

15-101-20202-00-00

STATE OF KANSAS
STATE CORPORATION COMMISSION

WELL PLUGGING RECORD

Give All Information Completely
Make Required Affidavit
Mail or Deliver Report to
Conservation Division
State Corporation Comm.
245 North Water
Wichita, KS 67202

Lane _____ County. 16 Twp. 16 Rge. 28W E/W
Location as "NE/CNW 1/4 SW 1/4" or footage from lines _____
NE NW SE

Lease Owner Graham-Michaelis Corporation
Lease Name Lawrence Well No. 1-16

Office Address P. O. Box 247, Wichita, Ks. 67201
Character of Well (Completed as Oil, Gas or Dry Hole) _____


Dry Hole

Date Well completed 12-14- 19 76
Application for plugging filed 12-14 19 76
Application for plugging approved 12-14 19 76
Plugging commenced 12-14 19 76
Plugging completed 12-14 19 76

Reason for abandonment of well or producing formation _____
No commercial quantities of oil or gas encountered.
If a producing well is abandoned, date of last production _____ 19 _____

Was permission obtained from the Conservation Division or its agents before plugging was commenced? Yes

Name of Conservation Agent who supervised plugging of this well Gilbert Balthazor
Producing formation _____ Depth to top _____ Bottom _____ Total Depth of Well 4540
Show depth and thickness of all water, oil and gas formations.

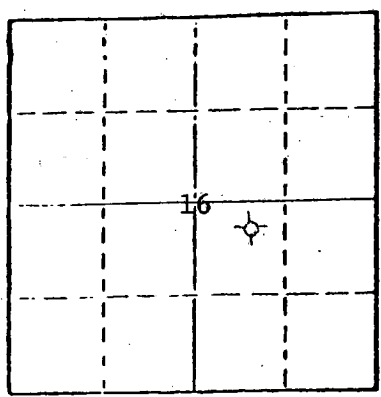

Locate well correctly on above Section Plot

OIL, GAS OR WATER RECORDS

CASING RECORD

FORMATION	CONTENT	FROM	TO	SIZE	PUT IN	PULLED OUT
Surface Hole	Shale	Surf.	208	8-5/8"	200	None

Describe in detail the manner in which the well was plugged, indicating where the mud fluid was placed and the method or methods used in introducing it into the hold. If cement or other plugs were used, state the character of same and depth placed, from _____ feet to _____ feet for each plug set.

RECEIVED
STATE CORPORATION COMMISSION

JAN 03 1977
Fluid to 800', plug, 70 sx cement;
Fluid to 200', plug, 20 sx cement;
Fluid to 40', plug 1/2 sx hulls, 10 sx cement;

CONSERVATION DIVISION
Wichita, Kansas

(If additional description is necessary, use BACK of this sheet.)

Name of Plugging Contractor D N B DRILLING, INC.
701 First National Building
Wichita, Kansas 67202

STATE OF KANSAS COUNTY OF _____, ss.
JAMES L. DONELSON (employee of owner) or (owner or operator)
of the above-described well, being first duly sworn on oath, says: That I have knowledge of the facts, statements, and matters herein contained and the log of the above-described well as filed and that the same are true and correct. So help me God.

(Signature) James L. Donelson
701 First Nat'l Bldg., Wichita, Kansas
(Address)

SUBSCRIBED AND SWORN TO before me this 28th day of Dec., 19 76

Ella Priess
Notary Public.

My commission expires 8-25-80

Ella Priess



15-101-20202-00-00

DRILLERS' LOG

GRAHAM-MICHAELIS CORPORATION
Lawrence #1-16
NE NW SE, Sec. 16-16-28W
Lane County, Kansas

Elev: 2698 K.B.

Commenced: 12-3-76
Completed: 12-14-76

Surface Casing: 200' of
8-5/8" cemented w/ 150 sx
common cement, 2% Gal, 3% cc.
12-3-76

<u>FORMATION</u>	<u>DEPTH</u>
Surface Hole	0 - 208
Sand & Shale	208 - 740
Shale & Sand	740 - 1495
Shale	1495 - 1650
Sand	1650 - 1885
Shale & Red Bed	1885 - 2105
Anhydrite	2105 - 2141
Shale	2141 - 2549
Lime & Shale	2549 - 2898
Shale	2898 - 3270
Lime & Shale	3270 - 3820
Lime	3820 - 3920
Lime & Shale	3920 - 3950
Lime	3950 - 4540

I do hereby certify that the foregoing statements are true and correct to the best of my knowledge and belief.

D N B DRILLING, INC.

James L. Donelson
JAMES L. DONELSON

STATE OF KANSAS: ss:

Subscribed and sworn to before me this 28th day of December, 1976.

Ella Priess

Ella Priess, Notary Public

