


15-101-20445-00-00

STATE OF KANSAS  
STATE CORPORATION COMMISSION

WELL PLUGGING RECORD

Give All Information Completely  
Make Required Affidavit  
Mail or Deliver Report to  
Conservation Division  
State Corporation Comm.  
245 North Water  
Wichita, KS 67202

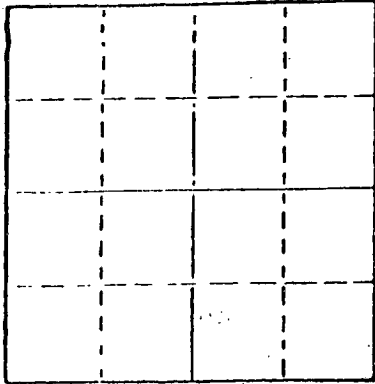

Locate well correctly on above  
Section Plat

Lane \_\_\_\_\_ County. Sec. 14 Twp. 16S Rge. 28W E/W  
Location as "NE/CNW 1/4 SW 1/4" or footage from lines  
C SE NW NESW JDKCC

Lease Owner Voyager Petroleum, Inc.  
Lease Name Ruby Ryan Well No. 2  
Office Address 800 Petroleum Bldg, 110-16th St. Denver, CO  
Character of Well (Completed as Oil, Gas or Dry Hole) \_\_\_\_\_  
dry hole

Date Well completed May 3, 1980  
Application for plugging filed May 3, 1980  
Application for plugging approved May 3, 1980  
Plugging commenced May 3, 1980  
Plugging completed May 4, 1980

Reason for abandonment of well or producing formation \_\_\_\_\_  
dry hole

If a producing well is abandoned, date of last production \_\_\_\_\_  
19 \_\_\_\_\_

Was permission obtained from the Conservation Division or  
its agents before plugging was commenced? yes

Name of Conservation Agent who supervised plugging of this well Gilbert Balthazor  
Producing formation \_\_\_\_\_ Depth to top \_\_\_\_\_ Bottom \_\_\_\_\_ Total Depth of Well 4,551'  
Show depth and thickness of all water, oil and gas formations.


OIL, GAS OR WATER RECORDS

CASING RECORD

FORMATION	CONTENT	FROM	TO	SIZE	PUT IN	PULLED OUT
				8-5/8"	224'	--

Describe in detail the manner in which the well was plugged, indicating where the mud fluid was placed and the method or methods used in introducing it into the hold. If cement or other plugs were used, state the character of same and depth placed, from \_\_\_\_\_ feet to \_\_\_\_\_ feet for each plug set.

Mud to 1,000', 70 sacks cement  
Mud to 200', 20 sacks cement  
Mud to 40', plug, 1/4 sack hulls  
10 sacks cement

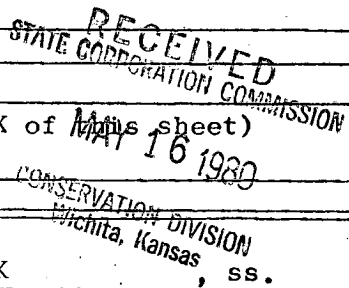


(If additional description is necessary, use BACK of this sheet)  
Name of Plugging Contractor \_\_\_\_\_

STATE OF KANSAS COUNTY OF SEDGWICK  
Donald E. Hunt (employee of owner) ~~owner or operator~~

of the above-described well, being first duly sworn on oath, says: That I have knowledge of the facts, statements, and matters herein contained and the log of the above-described well as filed and that the same are true and correct. So help me God.

(Signature) Donald E. Hunt  
Suite 250, 200 W. Douglas, Wichita, KS 67202  
(Address)

Subscribed and sworn to before me this 13th day of May, 1980

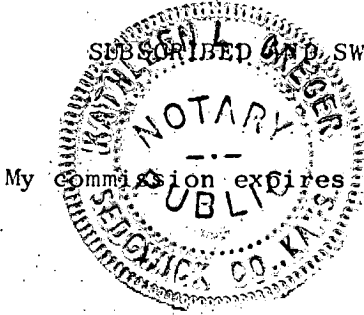

My Commission expires January 4, 1981

Kathleen L. Greger  
Kathleen L. Greger, Notary Public.

