

STATE OF KANSAS
STATE CORPORATION COMMISSION
200 Colorado Derby Building
Wichita, Kansas 67202

WELL PLUGGING RECORD
K.A.R.-82-3-117

API NUMBER 15-101-21,109 **00-00**

LEASE NAME James A

WELL NUMBER 1-6

SPOT LOCATION NW NW NE

SEC. 6 TWP. 16 RGE. 28 (E) or (W) **(W)**

COUNTY Lane

Date Well Completed 1-2-85

Plugging Commenced 1-2-85

Plugging Completed 1-2-85

TYPE OR PRINT
NOTICE: Fill out completely
and return to Cons. Div.
office within 30 days.

LEASE OPERATOR Landmark Oil Exploration

ADDRESS 105 S. Broadway, Suite 1040, Wichita, KS 67202

PHONE # (316) 265-8181 OPERATORS LICENSE NO. 6113

Character of Well D & A
(Oil, Gas, D&A, SWD, Input, Water Supply Well)

Did you notify the KCC/KDHE Joint District Office prior to plugging this well? Yes

Which KCC/KDHE Joint Office did you notify? District #1

Is ACO-1 filed? No If not, is well log attached? Yes

Producing formation N/A Depth to top _____ bottom _____ T.D. 4335

Show depth and thickness of all water, oil and gas formations.

OIL, GAS OR WATER RECORDS

CASING RECORD

Formation	Content	From	To	Size	Put in	Pulled out
				8 5/8	332'	None

Describe in detail the manner in which the well was plugged, indicating where the mud fluid was placed and the method or methods used in introducing it into the hole. If cement or other plugs were used state, the character of same and depth placed, from _____ feet to _____ feet each set.

Spotted 40 sx cement @ 1900' thru drill pipe.

Spotted 30 sx cement @ 800' thru drill pipe.

Spotted 40 sx cement @ 380' thru drill pipe.

Spotted 10 sx cement @ 40' thru drill pipe.

Spotted 15 sx cement in rathole.

(If additional description is necessary, use BACK of this form.)

Name of Plugging Contractor White & Ellis Drilling, Inc. License No. 5420

Address 401 East Douglas, Suite 500, Wichita, Ks. 67202

STATE OF Kansas COUNTY OF Sedgwick, ss.

RECEIVED
STATE CORPORATION COMMISSION


Ernest Sifford (employee of operator) or (operator) of above-described well, being first duly sworn on oath, says: That I have knowledge of the facts, statements, and matters herein contained and the log of the above-described well as filed that the same are true and correct, so help me God.

JAN 18 1985

(Signature) Ernest Sifford CONSERVATION DIVISION
Wichita, Kansas


(Address) 401 E. Douglas, Suite 500
Wichita, Ks. 67202

Subscribed and sworn to before me this 16th day of January, 1985

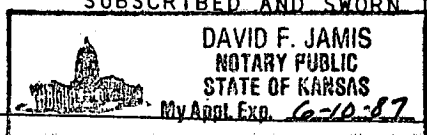

David F. Jamis
Notary Public

My Commission expires:

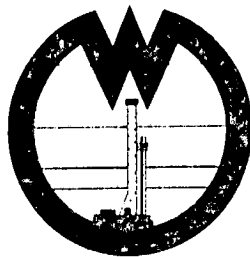

15-101-21109-00-00

WHITE

AND ELLIS DRILLING, Inc.

DRILLERS LOG

OPERATOR: Landmark Oil Exploration
 105 S. Broadway, Suite 1040
 Wichita, Kansas 67202

CONTRACTOR: White & Ellis Drilling, Inc., 401 E. Douglas, Suite 500,
 Wichita, Ks. 67202

Lease Name James A Well No. #1-6

Sec. 6 T. 16S R. 28W Spot NW NW NE

County Lane State Kansas Elevation

Casing Record:

Surface: 8 5/8" @ 332' with 215 sx., 2% gel, 3% cc

Production: @ with sx.

Type Well: D & A Total Depth 4335'

Drilling Commenced 12-21-84 Drilling Completed 1-2-85

Formation	From	To	Tops
Cellar	0	7	Anhydrite - 1934
Lime, Shale	7	1688	
Lime, Shale, Sand	1688	1934	
Lime, Shale	1934	3055	
Lime	3055	3365	
Lime, Shale	3365	4065	
Lime	4065	4251	
Lime, Shale	4251	4335	