

SIDE ONE

Two (2) copies of this form shall be filed with the Kansas Corporation Commission, 200 Colorado Derby Building, Wichita, Kansas 67202, within thirty (30) days after the completion of a well, regardless of how the well was completed.

Attach separate letter of request if the information is to be held confidential. If confidential, only file one copy. Information on Side One will be of public record and Side Two will then be held confidential.

Applications must be made on dual completion, commingling, salt water disposal, injection and temporarily abandoned wells.

Attach one copy only wireline logs (i.e. electrical log, sonic log, gamma ray neutron log, etc.). (Rules 82-2-105 & 82-2-125) KCC# (316) 263-3238.

LICENSE # 6009 EXPIRATION DATE 6-30-83

OPERATOR Double Eagle Exploration, Inc. API NO. 15-101-20,713-00-00

ADDRESS 100 S. Main - Suite 410 COUNTY Lane

Wichita, Kansas 67202 FIELD

** CONTACT PERSON Jim Robinson PROD. FORMATION

PHONE 267-3316

PURCHASER LEASE Mowery

ADDRESS WELL NO. #1

DRILLING Rains & Williamson Oil Co., Inc. WELL LOCATION SE NW SW

CONTRACTOR 990 Ft. from West Line and

ADDRESS 435 Page Court, 220 W. Douglas 1320 Ft. from South Line of

Wichita, Kansas 67202 the SW (Qtr.) SEC 20 TWP 16S RGE 28W.

PLUGGING Same

CONTRACTOR

ADDRESS

TOTAL DEPTH 3954' PBTD

SPUD DATE 11-8-82 DATE COMPLETED 11-14-82

ELEV: GR 2761 DF KB 2771

DRILLED WITH (CABLE) (ROTARY) (AIR) TOOLS.

DOCKET NO. OF DISPOSAL OR REPRESSURING WELL BEING USED TO DISPOSE OF WATER FROM THIS LEASE


Amount of surface pipe set and cemented 286' DV Tool Used?

THIS AFFIDAVIT APPLIES TO: (Circle ONE) - Oil, Gas, Shut-in Gas, Dry, Disposal, Injection, Temporarily Abandoned, OWWO. Other

ALL REQUIREMENTS OF THE STATUTES, RULES AND REGULATIONS PROMULGATED TO REGULATE THE OIL AND GAS INDUSTRY HAVE BEEN FULLY COMPLIED WITH.

WELL PLAT

(Office Use Only)

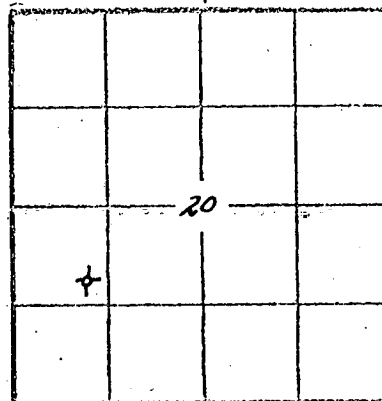

KCC [checked] KGS [checked] SWD/REP PLG.

A F F I D A V I T

JIM ROBINSON, being of lawful age, hereby certifies that:

I am the Affiant, and I am familiar with the contents of the foregoing Affidavit. The statements and allegations contained therein are true and correct.

Signature of Jim Robinson (Name)

SUBSCRIBED AND SWORN TO BEFORE ME this 30th day of November, 1982.

Signature of Leslie K. Robinson (NOTARY PUBLIC)

MY COMMISSION EXPIRES: 5-27-85

RECEIVED STATE CORPORATION COMMISSION

LESIE K. ROBINSON NOTARY PUBLIC STATE OF KANSAS MY APPT. EXPIRES 5-27-85

** The person who can be reached by phone regarding any questions concerning this information.

FILL IN WELL LOG AS REQUIRED:

Show all important zones of porosity and contents thereof; cored intervals, and all drill-stem tests, including depth interval tested, cushion used, time tool open, flowing and shut-in pressures, and recoveries.

SHOW GEOLOGICAL MARKERS, LOGS RUN, OR OTHER DESCRIPTIVE INFORMATION.

FORMATION DESCRIPTION, CONTENTS, ETC.	TOP	BOTTOM	NAME	DEPTH
Sand, Clay & Shale		290	<u>SAMPLES:</u>	
Shale		1790	Anhydrite	2171' + 600
Sand		1932	B. Anhydr	2201' + 570
Shale & Sand		1960	Queen Hill	3806' - 1035
Shale		2172	Heebner	3938' - 1167
Shale & Lime		2245		
Sand & Shale		2700	<u>LOG:</u>	
Lime & Shale		2790	Anhydrite	2173' + 598
Shale & Lime		3655	B. Anhydr	2204' + 567
Lime		3810	Queen Hill	3809' - 1038
Lime & Shale		3954		
ROTARY TOTAL DEPTH		3954		

Report of all strings set— surface, intermediate, production, etc. CASING RECORD (New) or (Used)

Purpose of string	Size hole drilled	Size casing set (in O.D.)	Weight lbs/ft.	Setting depth	Type cement	Sacks	Type and percent additives
Surface	12 1/4"	8 5/8"	20#	286'	Common	175 sx.	2% gel, 3% cc.

LINER RECORD

PERFORATION RECORD

Top, ft.	Bottom, ft.	Sacks cement	Shots per ft.	Size & type	Depth interval

Size	Setting depth	Packer set at

ACID, FRACTURE, SHOT, CEMENT SQUEEZE RECORD

Amount and kind of material used	Depth interval treated

Date of first production	Producing method (flowing, pumping, gas lift, etc.)	Gravity		
RATE OF PRODUCTION PER 24 HOURS	Oil	Gas	Water %	Gas-oil ratio
Disposition of gas (vented, used on lease or sold)	Perforations			