

STATE CORPORATION COMMISSION OF KANSAS
OIL & GAS CONSERVATION DIVISION

WELL COMPLETION OR RECOMPLETION FORM
ACO-1 WELL HISTORY

DESCRIPTION OF WELL AND LEASE

Operator: License # ... 5151
Name ... Gear Petroleum Co. Inc.
Address 300 Sutton Place
City/State/Zip ... Wichita, Kansas 67202

Purchaser ... Inland Crude Purchasing
200 Douglas Blvd. Wichita, KS

Operator Contact Person ... Jim Thatcher
Phone ... 316.265.3351

Contractor: License # ... 5302
Name ... Red Tiger Drilling Co.

Wellsite Geologist ... Casey Galloway
Phone ... 316.267.6248

Designate Type of Completion
 New Well Re-Entry Workover
 Oil SWD Temp Abd
 Gas Inj Delayed Comp.
 Dry Other (Core, Water Supply etc.)

If OWWO: old well info as follows:
Operator
Well Name
Comp. Date
Old Total Depth

WELL HISTORY

Drilling Method:
 Mud Rotary Air Rotary Cable
11/8/84 11/18/84 1/4/85
Spud Date Date Reached TD Completion Date
4704 4635
Total Depth PBD


Amount of Surface Pipe Set and Cemented at 345 feet
Multiple Stage Cementing Collar Used? Yes No
If yes, show depth set 1111 feet
if alternate 2 completion, cement circulated
from 1111 feet depth to surface 250 SX cmt

API NO. 15-... 101-21077-00-00
County ... Lane
NE NW NW 15 18 27 East
Sec... Twp... Rge... West

4950 Ft North from Southeast Corner of Section
4230 Ft West from Southeast Corner of Section
(Note: Locate well in section plat below)

Lease Name ... Neeley Well # 1-15
Field Name ... Wildcat ALAMOTA
Producing Formation ... Cherokee

Elevation: Ground 2683 KB 2688
Section Plat

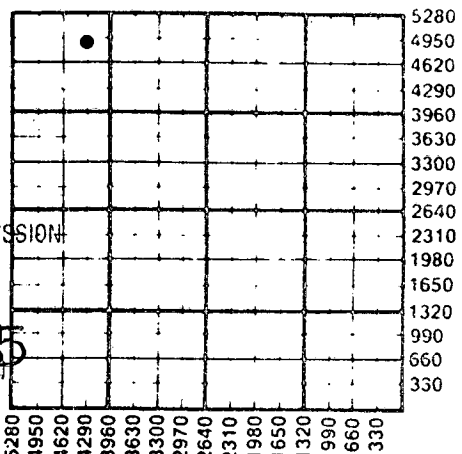

RECEIVED
STATE CORPORATION COMMISSION
JAN 10 1985
CONSERVATION DIVISION
Wichita, Kansas

WATER SUPPLY INFORMATION

Disposition of Produced Water: Disposal
Docket # Repressuring

Questions on this portion of the ACO-1 call:

Water Resources Board (913) 296-3717
Source of Water:
Division of Water Resources Permit #
 Groundwater... Ft North from Southeast Corner (Well) ... Ft West from Southeast Corner of Sec Twp Rge East West
 Surface Water 4900 Ft North from Southeast Corner (Stream, pond etc.) 350 Ft West from Southeast Corner Sec 32 Twp 17 Rge 27 East West
 Other (explain)
Purchased from: Jerry Erskin, Shields, KS (purchased from city, R.W.D. #)

INSTRUCTIONS: This form shall be completed in duplicate and filed with the Kansas Corporation Commission, 200 Colorado Derby Building, Wichita, Kansas 67202, within 90 days after completion or recompletion of any well. Rule 82-3-130 and 82-3-107 apply. Information on side two of this form will be held confidential for a period of 12 months if requested in writing and submitted with the form. See rule 82-3-107 for confidentiality in excess of 12 months. One copy of all wireline logs and drillers time log shall be attached with this form. Submit CP-4 form with all plugged wells. Submit CP-111 form with all temporarily abandoned wells.

All requirements of the statutes, rules and regulations promulgated to regulate the oil and gas industry have been fully complied with and the statements herein are complete and correct to the best of my knowledge.

Signature ...
Title ... Drilling & Production Manager Date 1/9/85
Subscribed and sworn to before me this 9th day of January 1985.
Notary Public ... Helen L. Cover
Date Commission Expires ... April 1, 1986

K.C.C. OFFICE USE ONLY
 Letter of Confidentiality Attached
 Wireline Log Received
 Drillers Timelog Received
Distribution
 KCC SWD/Rep NGPA
 KGS Plug Other (Specify)

HELEN L. COVER
NOTARY PUBLIC
STATE OF KANSAS
My Appt. Exp. 4-1-86

Operator Name Gear Petroleum Co., Inc. Lease Name Neeley Well # 1-15

Sec. 15 Twp. 18S Rge. 27 County Lane

WELL LOG

INSTRUCTIONS: Show important tops and base of formations penetrated. Detail all cores. Report all drill stem tests giving interval tested, time tool open and closed, flowing and shut-in pressures, whether shut-in pressure reached static level, hydrostatic pressures, bottom hole temperature, fluid recovery, and flow rates if gas to surface during test. Attach extra sheet if more space is needed. Attach copy of log.

Drill Stem Tests Taken [X] Yes [] No
Samples Sent to Geological Survey [X] Yes [] No
Cores Taken [] Yes [X] No

Formation Description [X] Log [] Sample

Table with 3 columns: Name, Top, Bottom. Rows include Anhydrite, Heebner, LKC, Marmaton, Ft. Scott, Cherokee, Mississippi.

RELEASED

MAY 29 1986

FROM CONFIDENTIAL

RECEIVED STATE CORPORATION COMMISSION

CONSERVATION DIVISION Wichita, Kansas

Form sections: CASING RECORD, PERFORATION RECORD, TUBING RECORD, Date of First Production, Estimated Production, METHOD OF COMPLETION.

Disposition of gas: [] Vented, [] Sold, [] used on Lease, [] Open Hole, [] Other (Specify), [X] Perforation, [] Dually Completed, [] Commingled. Production Interval: 4576-87