

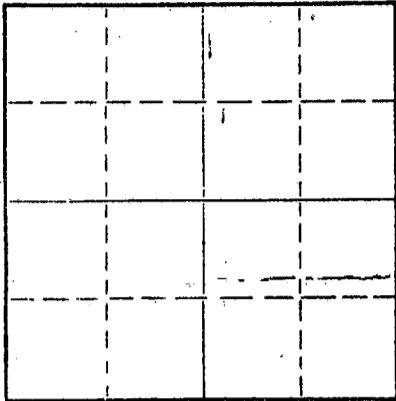
15-135-21075-00-00

STATE OF KANSAS  
STATE CORPORATION COMMISSION

Form CP-4

Give All Information Completely  
Make Required Affidavit  
Mail or Deliver Report to:  
Conservation Division  
State Corporation Commission  
P. O. Box 17027  
Wichita, Kansas 67217  
NORTH

WELL PLUGGING RECORD



Locate well correctly on above  
Section Plat

Ness County, Sec. 19 Twp. 16S Rge. 25W (E) (W)  
Location as "NE/CNWxSWx" or footage from lines C SE SW  
Lease Owner Chief Drilling Co., Inc.  
Lease Name Lynn-Pickering Well No. 1  
Office Address 905 Century Plaza, Wichita, Kansas 67202  
Character of Well (completed as Oil, Gas or Dry Hole) Dry Hole  
Date well completed 8/6/75 19  
Application for plugging filed 8/6/75 19  
Application for plugging approved 8/6/75 19  
Plugging commenced 8/6/75 19  
Plugging completed 8/6/75 19  
Reason for abandonment of well or producing formation Dry hole

If a producing well is abandoned, date of last production 19  
Was permission obtained from the Conservation Division or its agents before plugging was commenced? Yes

Name of Conservation Agent who supervised plugging of this well Leo Massey  
Producing formation \_\_\_\_\_ Depth to top \_\_\_\_\_ Bottom \_\_\_\_\_ Total Depth of Well 4564 Feet  
Show depth and thickness of all water, oil and gas formations.

OIL, GAS OR WATER RECORDS

CASING RECORD

FORMATION	CONTENT	FROM	TO	SIZE	PUT IN	PULLED OUT

Describe in detail the manner in which the well was plugged, indicating where the mud fluid was placed and the method or methods used in introducing it into the hole. If cement or other plugs were used, state the character of same and depth placed, from \_\_\_\_\_ feet to \_\_\_\_\_ feet for each plug set.

Plugged through drill pipe @ 750' w/70 sacks cement  
Plugged through drill pipe @ 240' w/20 sacks cement  
Plugged through drill pipe @ 40' w/10 sacks cement

RECEIVED  
STATE CORPORATION COMMISSION

AUG 11 1975

CONSERVATION DIVISION  
Wichita, Kansas

(If additional description is necessary, use BACK of this sheet)

Name of Plugging Contractor Chief Drilling Co., Inc.  
Address 905 Century Plaza, Wichita, Kansas 67202

STATE OF KANSAS, COUNTY OF SEDGWICK, ss.  
Jim Robinson (employee of owner) or (OWNER/OPERATOR) of the above-described well, being first duly sworn on oath, says: That I have knowledge of the facts, statements, and matters herein contained and the log of the above-described well as filed and that the same are true and correct. So help me God.

(Signature) Jim Robinson

905 Century Plaza, Wichita, Kansas 67202  
(Address)

SUBSCRIBED AND SWORN TO before me this 6th day of August, 1975

Marilyn Sinard  
Marilyn Sinard  
Notary Public.

My commission expires

MARILYN SINARD  
STATE NOTARY PUBLIC  
SEDGWICK COUNTY, KANSAS  
MY COMM. EXP. APR. 30, 1979

15-135-21075-00-08

WELL LOG

CHIEF DRILLING CO., INC.  
905 Century Plaza  
Wichita, Kansas 67202

#1 LYNN-PICKERING  
C SE SW Sec. 19-16S-25W  
Ness County, Kansas

CONTRACTOR: Chief Drilling Co., Inc.  
CASING RECORD: Ran (7 Jts.) 263' used 28# set @  
269', cemented w/175 sacks Common  
Quick Set.

COMMENCED: 7/27/75  
COMPLETED: 8/6/75

FORMATION	FROM	TO	ELEVATIONS
Surface Hole	0	275	2594 Gr.
Shale & Sand	275	2181	2597 D.F.
Shale	2181	2929	2599 K.B.
Lime	2929	3295	
Lime & Shale	3295	3510	
Lime	3510	4564	
Total Depth	4564		

FORMATION TOPS

Anhydrite	1965 + 634
Base Anhy.	2004 + 595
Heebner	3855 - 1256
Toronto	3874 - 1275
Lansing-K.C.	3894 - 1295
Base K.C.	4211 - 1612
Marmaton	4223 - 1625
Fort Scott	4408 - 1809
Miss. Dolo.	4508 - 1909
Total Depth	4564 - 1965

RECEIVED  
STATE CORPORATION COMMISSION

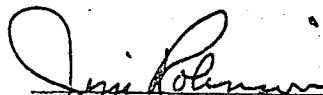
AUG 11 1975

CONSERVATION DIVISION  
Wichita, Kansas

STATE OF KANSAS, COUNTY OF SEDGWICK) ss:

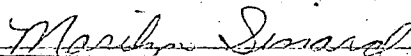
I hereby certify that the above is a true and correct copy of the  
Driller's Log of the well drilled in the C SE SW Sec. 19-16S-25W  
Ness County, Kansas, to the best  
of my knowledge and belief.

CHIEF DRILLING CO., INC.

  
Jim Robinson, Vice-President

Subscribed and sworn to before me this 8th day of August, 1975.

MARILYN SINARD  
STATE NOTARY PUBLIC  
SEDGWICK COUNTY, KANSAS  
MY COMM. EXP. APR. 30, 1979

  
Marilyn Sinard - Notary Public