


Give All Information Completely  
Make Required Affidavit  
Mail or Deliver Report to:  
Conservation Division  
State Corporation Commission  
211 No. Broadway  
Wichita, Kansas

WELL PLUGGING RECORD

Lane \_\_\_\_\_ County. Sec. 31 Twp. 18S Rge. 27W (E) (W)

Location as "NE/CNW/SW" or footage from lines C-SW-NE  
Lease Owner Davis Brothers Oil Producers  
Lease Name Alexander "A" Well No. 1  
Office Address Tulsa, Oklahoma  
Character of Well (completed as Oil, Gas or Dry Hole) Dry Hole  
Date well completed 12-15 19 62  
Application for plugging filed 12-14 19 62  
Application for plugging approved 12-15 19 62  
Plugging commenced 12-15 19 62  
Plugging completed 12-15 19 62  
Reason for abandonment of well or producing formation \_\_\_\_\_

NORTH

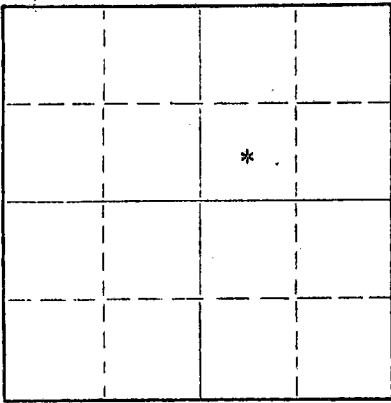

Locate well correctly on above Section Plat

If a producing well is abandoned, date of last production \_\_\_\_\_ 19\_\_\_\_  
Was permission obtained from the Conservation Division or its agents before plugging was commenced? Yes

Name of Conservation Agent who supervised plugging of this well Eldon Petty  
Producing formation \_\_\_\_\_ Depth to top \_\_\_\_\_ Bottom \_\_\_\_\_ Total Depth of Well 4650 Feet  
Show depth and thickness of all water, oil and gas formations.

OIL, GAS OR WATER RECORDS

CASING RECORD

| FORMATION | CONTENT | FROM | TO  | SIZE  | PUT IN | PULLED OUT |
|-----------|---------|------|-----|-------|--------|------------|
|           |         | 0    | 158 | 8 5/8 | 158    | 0          |
|           |         |      |     |       |        |            |
|           |         |      |     |       |        |            |
Describe in detail the manner in which the well was plugged, indicating where the mud fluid was placed and the method or methods used in introducing it into the hole. If cement or other plugs were used, state the character of same and depth placed, from \_\_\_\_\_ feet to \_\_\_\_\_ feet for each plug set.

Filled hole with heavy mud to 600', 1/2 sack hulls, plug and 20 sacks cement. Filled hole with heavy mud to 180', 1/2 sack hulls, plug, and 20 sacks cement. Mud hole up to 35', 1/2 sack hulls, plug, and 10 sacks cement to surface.

RECEIVED  
STATE CORPORATION COMMISSION

DEC 20 1962  
12-20-1962  
CONSERVATION DIVISION  
Wichita, Kansas

(If additional description is necessary, use BACK of this sheet)

Name of Plugging Contractor Terrel Drilling and Producing  
Address Russell, Kansas

STATE OF KANSAS, COUNTY OF RUSSELL, ss.  
Joe K. Branum, Contractor, (employee of owner or owner or operator) of the above-described well, being first duly sworn on oath, says: That I have knowledge of the facts, statements, and matters herein contained and the log of the above-described well as filed and that the same are true and correct. So help me God.

(Signature) Joe K. Branum  
Russell, Kansas (Address)

SUBSCRIBED AND SWORN to before me this 17th day of December, 19 62  
My commission expires November 13, 1963.  
Mary Boma Branum Notary Public.



