

15-101-20606-00-00


STATE OF KANSAS
STATE CORPORATION COMMISSION

Form CP-4

Give All Information Completely
Make Required Affidavit
Mail or Deliver Report to:
Conservation Division
State Corporation Commission
P. O. Box 17027
Wichita, Kansas 67217
NORTH

WELL PLUGGING RECORD

Lane _____ County. Sec. 14 Twp. 17S Rge. _____ (E) 27W (W) _____
Location as "NE/CNW/SW" or footage from lines 330' FSL & 520' FWL of NW/4
Lease Owner Donald C. Stawson
Lease Name Hagans 'N' Well No. 1
Office Address 200 Douglas Building Wichita, Kansas 67202
Character of Well (completed as Oil, Gas or Dry Hole) Dry Hole
Date well completed January 31, 19 82
Application for plugging filed January 31, 19 82
Application for plugging approved January 31, 19 82
Plugging commenced January 31, 19 82
Plugging completed January 31, 19 82
Reason for abandonment of well or producing formation Dry Hole

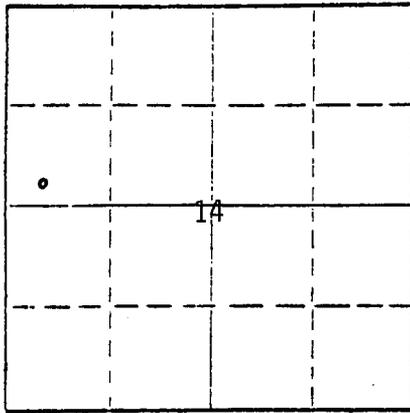

Locate well correctly on above Section Plat

If a producing well is abandoned, date of last production _____ 19 _____
Was permission obtained from the Conservation Division or its agents before plugging was commenced? Yes

Name of Conservation Agent who supervised plugging of this well Clarence Thomas
Producing formation _____ Depth to top _____ Bottom _____ Total Depth of Well 4630 Feet
Show depth and thickness of all water, oil and gas formations.

OIL, GAS OR WATER RECORDS

CASING RECORD

FORMATION	CONTENT	FROM	TO	SIZE	PUT IN	PULLED OUT
		Surface	376'	8 5/8"		

Describe in detail the manner in which the well was plugged, indicating where the mud fluid was placed and the method or methods used in introducing it into the hole. If cement or other plugs were used, state the character of same and depth placed, from _____ feet to _____ feet for each plug set.

1st plug @ 1260' w/70 sx
2nd plug @ 360' w/40 sx
Top plug @ 40' w/10 sx
10 sx in Rat Hole

RECEIVED
STATE CORPORATION COMMISSION

MAR 10 1982

CONSERVATION DIVISION

(If additional description is necessary, use BACK of this sheet)

Name of Plugging Contractor Allied Cementing Co., Inc.
Address Box 31 Russell, Kansas 67665

STATE OF KANSAS COUNTY OF SEDGWICK ss.

William R. Horigan (employee of owner) or (owner or operator) of the above-described well, being first duly sworn on oath, says: That I have knowledge of the facts, statements, and matters herein contained and the log of the above-described well as filed and that the same are true and correct. So help me God.

SHERRY L. KENDALL
STATE NOTARY PUBLIC
Sedgwick County, Kansas
My Appt. Exp. 6/12/82

(Signature) William R. Horigan
200 Douglas Building Wichita, Kansas 67202
(Address)

Subscribed and sworn to before me this 1st day of March, 19 82

My commission expires 06/12/82

Sherry L. Kendall
Sherry L. Kendall Notary Public.