

STATE OF KANSAS
STATE CORPORATION COMMISSION

Give All Information Completely
Make Required Affidavit
Mail or Deliver Report to:
Conservation Division
State Corporation Commission
211 No. Broadway
Wichita, Kansas


WELL PLUGGING RECORD

15-101-00040-00-00

Lane _____ County, Sec. 8 Twp. 17S Rge. 27W (E) (W)

Location as "NE/CNWxSWx" or footage from lines C SE SE NW
Lease Owner Helmerich & Payne, Inc.
Lease Name PFEIFER Well No. 1
Office Address Box 558, Garden City, Kansas
Character of Well (completed as Oil, Gas or Dry Hole) Dry
Date well completed 10-12-62 19____
Application for plugging filed 10-12-62 19____
Application for plugging approved 10-12-62 19____
Plugging commenced 10-12-62 19____
Plugging completed 10-12-62 19____
Reason for abandonment of well or producing formation Dry Hole

NORTH

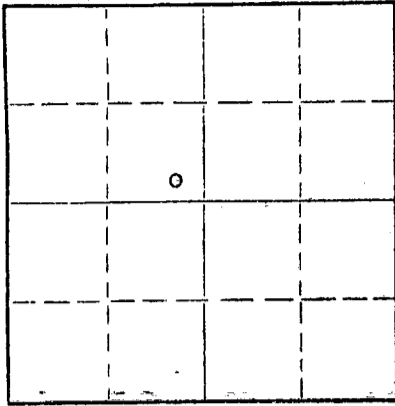

Locate well correctly on above Section Plat

If a producing well is abandoned, date of last production _____ 19____
Was permission obtained from the Conservation Division or its agents before plugging was commenced? Yes

Name of Conservation Agent who supervised plugging of this well Eldon Petty Hays, Kansas
Producing formation _____ Depth to top _____ Bottom _____ Total Depth of Well 4720 Feet
Show depth and thickness of all water, oil and gas formations.

OIL, GAS OR WATER RECORDS

CASING RECORD

FORMATION	CONTENT	FROM	TO	SIZE	PUT IN	PULLED OUT
		4'	286	8-5/8"	286	None

Describe in detail the manner in which the well was plugged, indicating where the mud fluid was placed and the method or methods used in introducing it into the hole. If cement or other plugs were used, state the character of same and depth placed, from _____ feet to _____ feet for each plug set.

4720 to 660' Heavy Rotary Mud
660 to 600' -20 sacks of Pozmix cement
600 to 240' Heavy Rotary Mud
240 to 180' Plug, & 20 sacks of Pozmix cement
180 to 35' Heavy Rotary Mud
35 to 4' Plug, & 10 sacks of Pozmix cement
4' to 0' Cellar

Plugging Complete: 10:30 AM 10-12-62

RECEIVED
STATE CORPORATION COMMISSION

OCT 22 1962

CONSERVATION DIVISION
Wichita, Kansas


(If additional description is necessary, use BACK of this sheet)

Name of Plugging Contractor Helmerich & Payne, Inc.
Address First National Bldg, Tulsa, Okla

STATE OF Kansas, COUNTY OF Finney, ss.
T. E. Mort (employee of owner) or (owner/operator) of the above-described well, being first duly sworn on oath, says: That I have knowledge of the facts, statements, and matters herein contained and the log of the above-described well as filed and that the same are true and correct. So help me God.

(Signature) T. E. Mort
Box 558, Garden City, Kansas
(Address)

Subscribed and sworn to before me this 15 day of October, 19 62

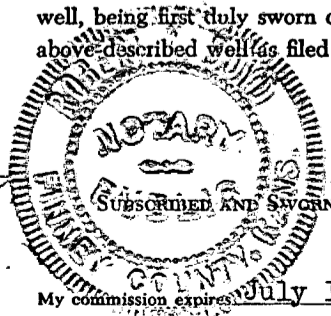

Robert N. Boyd
Robert N. Boyd Notary Public.

15-101-00040-00-00

Lita Pfeifer #1
Helmerich & Payne, Inc.
Section 8-17S-27W
Lane County, Kansas

Well Log

Casing Record:
13 Joints 8-5/8" @ 286' w/200 sxs.
P&A

Commenced: 9-30-62
Completed: '0-12-62

	<u>FROM</u>	<u>TO</u>
Shale	0	290
Shale	290	1375
Shale, Red Bed and Anhydrite	1375	2206
Shale	2206	2479
Shale & Lime	2479	2940
Shale & Anhydrite	2940	3095
Shale & Lime	3095	3978
Lime & Shale	3978	4006
Shale & Lime	4006	4082
Lime & Shale	4082	4204
Shale & Lime	4204	4319
Lime & Shale	4319	4396
Shale & Lime	4396	4471
Lime & Shale	4471	4522
Lime	4522	4585
Lime & Shale	4585	4647
Lime	4647	4720
<u>TOTAL DEPTH</u>		<u>4720</u>

RECEIVED
STATE CORPORATION COMMISSION

OCT 9 1962

CONSERVATION DIVISION
Wichita, Kansas

STATE OF OKLAHOMA)
) SS
County of Tulsa)

I hereby affirm that the above and foregoing is a true and correct copy of the log of the Lita Pfeifer #1 well, located in Section 8-17S-27W, Lane County, Kansas.

HELMERICH & PAYNE, INC.

[Signature]

Vice President

Subscribed and sworn to before me a Notary Public this 24th day of October, 1962.

[Signature]

Notary Public

My commission expires: March 30, 1964.

