

133-33

15-101-00012-00-00


STATE OF KANSAS
STATE CORPORATION COMMISSION

Give All Information Completely
Make Required Affidavit
Mail or Deliver Report to:
Conservation Division
State Corporation Commission
800 Bitting Building
Wichita, Kansas

WELL PLUGGING RECORD

Lane _____ County. Sec. 1 Twp. 17S Rge. 27W (E) _____ (W) _____
Location as "NE/CNW $\frac{1}{4}$ /SW $\frac{1}{4}$ " or footage from lines Cent. NW, NW, SE
Lease Owner Continental Oil Co.
Lease Name Hagan Well No. 1
Office Address Drawer 1267 Ponca City, Oklahoma
Character of Well (completed as Oil, Gas or Dry Hole) Dry Hole
Date well completed January 9, 1950
Application for plugging filed January 10, 1950
Application for plugging approved January 10, 1950
Plugging commenced January 10, 1950
Plugging completed January 11, 1950
Reason for abandonment of well or producing formation Dry Hole

NORTH

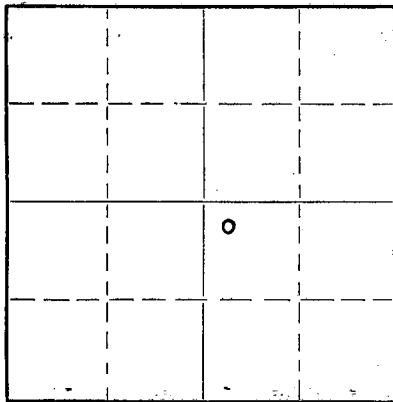

Locate well correctly on above
Section Flat

If a producing well is abandoned, date of last production _____ 19____
Was permission obtained from the Conservation Division or its agents before plugging was commenced? Yes

Name of Conservation Agent who supervised plugging of this well C. D. Stough
Producing formation _____ Depth to top _____ Bottom _____ Total Depth of Well 4700 Feet
Show depth and thickness of all water, oil and gas formations.

OIL, GAS OR WATER RECORDS

CASING RECORD

Formation	Content	From	To	Size	Put In	Pulled Out
		0	262'	13 3/8"	262'	none

Describe in detail the manner in which the well was plugged, indicating where the mud fluid was placed and the method or methods used in introducing it into the hole. If cement or other plugs were used, state the character of same and depth placed, from _____ feet to _____ feet for each plug set.
Hole was filled with heavy rotary mud. Wood plug was set at 255' and 26 sacks of cement placed on top of plug thru the drill-pipe. The hole was then filled # to ## ten feet where a wood plug was set and the hole filled to the top with cement.

(If additional description is necessary, use BACK of this sheet)

Correspondence regarding this well should be addressed to J. George Klein
Address Gen. Del. Hays, Kansas

STATE OF Kansas, COUNTY OF Edwards, ss.
J. George Klein (employee of owner) or (owner or operator) of the above-described well,


being first duly sworn on oath, says: That I have knowledge of the facts, statements, and matters herein contained and the log of the above-described well as filed and that the same are true and correct. So help me God.

(Signature) J. George Klein
Kinsley, Kansas
(Address)

SUBSCRIBED AND SWORN to before me this 6 day of April, 1950

Notary Public.

My commission expires Oct 18 1951

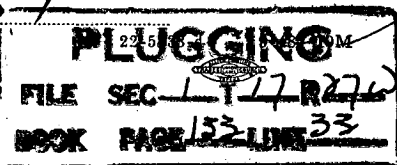

15-101-00012-00-00

DRILLERS' LOG (G-20)

Continental #1 Hagan Comm. 12-7-49 Comp. 3-15-50
 NW-NW-SE, Section 1-17S-27W, Lane County, Kansas Elevation 2560

0	48	Yellow shale
48	172	Gray shale
172	212	Chalk
212	447	Gray shale
447	598	Shale & lime strks
598	620	Shale
620	650	Sand
650	790	Shale
790	840	Red bed
840	860	Sandstone
860	875	Sandstone & shale
875	906	Sandstone
906	910	Shale & sandstone
910	930	Sandstone
930	960	Shale
960	999	Sandstone & shale
999	1090	Shale
1090	1093	Sandstone
1093	1105	Sandstone & shale
1105	1118	Lime
1118	1120	Limey shale
1120	1150	Red sandstone
1150	1160	White sandstone
1160	1279	Red shale
1279	1354	Red & blue shale
1354	1369	Shale & lime breaks
1369	1390	Red shale
1390	1398	Lime
1398	1430	Lime & shale
1430	1480	Red shale
1480	1491	Gray shale, lime breaks
1491	1523	Gray & red shale
1523	1616	Red shale
1616	1678	Gray and red shale
1678	1772	Red shale
1772	1780	Gyp & shale
1780	1798	Gyp
1798	1835	Red & blk shale
1835	1896	Red and gray shale
1896	1987	Red & blk shale
1987	2020	Anhy
2020	2040	Red & gray shale
2040	2100	Red shale
2100	2112	Shale & gyp
2112	2210	Shale & Anhy
2210	2235	Blue & gray shale
2235	2329	Red shale & gyp strks

TOPS

Anhy	1986
Lans	3877
Miss	4538

PLUGGING
 FILE SEC 1-T-17-R-270
 BOOK PAGE 133 LINE 333
 STATE OF KANSAS
 COMMISSIONER
 KANSAS

15-101-00012-00-00

2329	2391	Blue shale, lime strks
2391	2425	Shale
2425	2453	Shale & Anhy
2453	2505	Shale
2505	2580	Shale, anhy & gyp
2580	2615	Shale, lime & gyp
2615	2625	Shale
2625	2650	Lime
2650	2660	Lime & sdy shale
2660	2675	Shale
2675	2692	Lime
2692	2700	Lime, gyp & shale
2700	2710	Lime gyp & sdy shale
2710	2810	Shale & gyp
2810	2820	Lime, shale & gyp
2820	2830	Lime, shale & gyp & chert
2830	2840	Lime, shale & gyp
2840	2850	Lime & gyp & sdy shale
2850	2871	Lime
2871	2885	Lime & shale
2885	2900	Red shale
2900	2905	Lime & gyp
2905	2915	Lime & shale
2915	2935	Shale & gyp
2935	2955	Shale & lime
2955	2965	Sdy lime & shale
2965	2985	Lime
2985	3070	Lime & shale
2070	3091	Brn sdy lime
3091	3185	Shale & lime
3185	3230	Sdy lime & shale
3230	3330	Lime & shale
3330	3361	Shale
3361	3449	Shale & Lime
3449	3479	Lime
3479	3485	Lime & shale
3485	3558	Lime
3558	3587	Shale & lime
3587	3602	Lime
3602	3605	Lime & shale
3605	3635	Lime
3635	3648	Lime & shale
3648	3659	Lime
3659	3671	Blk shale & lime
3671	3676	Shale
3676	3717	Lime & shale
3717	3719	Lime
3719	3751	Lime & shale
3751	3847	Lime
3847	3868	Lime & shale
3868	3959	Lime
3959	3970	Lime & chert
3970	3975	Lime

JUL 7 - 1950
STATE GEOLOGICAL SURVEY
KANSAS

15-101-00012-00-00

3975	3980	Lime & chert
3980	4135	Lime
4135	4139	Lime & shale
4139	4149	Lime
4149	4170	Lime & shale
4170	4191	Lime
4191	4201	Shale
4201	4204	Lime & shale brks
4204	4205	Shale
4205	4235	Lime & shl breaks
4235	4257	Lime & shale
4257	4340	Lime
4340	4355	Lime & shale
4355	4364	Shale
4364	4373	Lime & shale
4373	4433	Shale & lime breaks
4433	4508	Sdy lime & shale
4508	4527	Lime & shale
4527	4548	Lime & shale & chert
4548	4585	Lime
4585	4594	Lime & shale.
4594	4663	Lime
4663	4683	Lime & shale
4683	4690	Lime, shale & chert
4690	4700	Lime & chert

RECORDED
 JUL 7 - 1950
 STA