

15-101-20441-00-00


STATE OF KANSAS  
STATE CORPORATION COMMISSION

WELL PLUGGING RECORD

Give All Information Completely  
Make Required Affidavit  
Mail or Deliver Report to  
Conservation Division  
State Corporation Comm.  
245 North Water  
Wichita, KS 67202

Lane \_\_\_\_\_ County. Sec. 5 Twp. 17 Rge. 27 E/W  
Location as "NE/CNW $\frac{1}{4}$ /SW $\frac{1}{4}$ " or footage from lines  
SE NE NW

Lease Owner Oxford Exploration Company  
Lease Name Linden #5-34 Well No. \_\_\_\_\_  
Office Address 1030 Denver Club Building, Denver 80202  
Character of Well (Completed as Oil, Gas or Dry Hole) \_\_\_\_\_  
Dry Hole

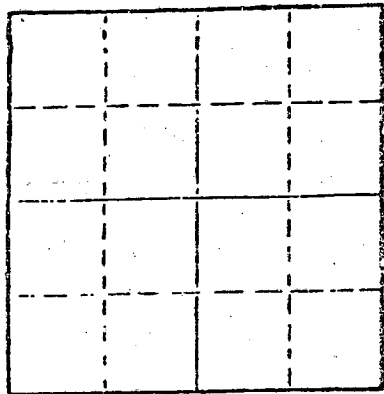

Locate well correctly on above  
Section Plot

Date Well completed 2/16/80 19  
Application for plugging filed 2/16/80 19  
Application for plugging approved 2/16/80 19  
Plugging commenced 2/16/80 19  
Plugging completed 2/16/80 19  
Reason for abandonment of well or producing formation \_\_\_\_\_

If a producing well is abandoned, date of last production \_\_\_\_\_ 19

Was permission obtained from the Conservation Division or  
its agents before plugging was commenced? yes

Name of Conservation Agent who supervised plugging of this well Gil Balthazor  
Producing formation \_\_\_\_\_ Depth to top \_\_\_\_\_ Bottom \_\_\_\_\_ Total Depth of Well \_\_\_\_\_  
Show depth and thickness of all water, oil and gas formations. TD 4320'

OIL, GAS OR WATER RECORDS

CASING RECORD

FORMATION	CONTENT	FROM	TO	SIZE	PUT IN	PULLED OUT
	Surface	0	369'	8-5/8"	yes	no

Describe in detail the manner in which the well was plugged, indicating where the mud fluid was placed and the method or methods used in introducing it into the hold. If cement or other plugs were used, state the character of same and depth placed, from \_\_\_\_\_ feet to \_\_\_\_\_ feet for each plug set.

1st plug @ 750' with 70 sacks  
2nd plug @ 360' with 20 sacks  
3rd plug @ 40' with 10 sacks  
5 sacks in rathole  
Job complete @ 6:45 p.m. 2/16/80

RECEIVED  
STATE CORPORATION COMMISSION  
FEB 22 1980  
CONSERVATION DIVISION  
Wichita, Kansas

(If additional description is necessary, use BACK of this sheet)

Name of Plugging Contractor Slawson Drilling Company, Inc.

STATE OF Kansas COUNTY OF Sedgwick, ss.  
James C. Remsberg, Slawson Drilling Co., Inc. (employee of owner) or (owner or operator of the above-described well, being first duly sworn on oath, says: That I have knowledge of the facts, statements, and matters herein contained and the log of the above-described well as filed and that the same are true and correct. So help me God.

(Signature) James C. Remsberg  
James C. Remsberg  
200 Douglas Building, Wichita, Kansas 67202  
(Address)

SUBSCRIBED AND SWORN TO before me this 20 day of February, 1980

Mary Lou Taylor  
Mary Lou Taylor Notary Public.

My commission expires January 17, 1981



DRILLERS LOG

15-101-20441-00-00

OPERATOR: Oxford Exploration Company  
 1030 Denver Club Building  
 Denver, Colorado 80202

LEASE: Linden#5-34  
 SE NE NW Sec. 5-17S-27W  
 Lane County, Kansas

CONTRACTOR: Slawson Drilling Co., Inc.  
 200 Douglas Building  
 Wichita, Kansas 67202

COMMENCED: 2/8/80

COMPLETED: 2/16/80

RTD: 4320'

SURFACE CASING: 8-5/8" set at 369' with 250 sx cement

0' to 375' 12 1/4" Surface Hole  
 375' to 2099' Shale  
 2099' to 2143' Anhydrite  
 2143' to 3285' Shale  
 3285' to 3560' Shale & Lime  
 3560' to 3695' Lime  
 3695' to 3900' Lime & Shale  
 3900' to 4320' Lime  
 RTD 4320'

STATE OF KANSAS

COUNTY OF SEDGWICK

I, James C. Remsberg, of the Slawson Drilling Company, Inc.  
 hereby state the above and foregoing is an accurate copy of the  
 Linden #5-34 log for the Oxford Exploration Company.

RECEIVED  
 STATE CORPORATION COMMISSION

FEB 22 1980

CONSERVATION DIVISION  
 Wichita, Kansas

*James C. Remsberg*  
 James C. Remsberg

Subscribed and sworn to me this  
 20th day of February 1980

*Mary Lou Taylor*  
 Mary Lou Taylor, Notary

My commission expires January 17, 1981

