


Give All Information Completely
Make Required Affidavit
Mail or Deliver Report to:
Conservation Division
State Corporation Commission
211 No. Broadway
Wichita, Kansas

WELL PLUGGING RECORD

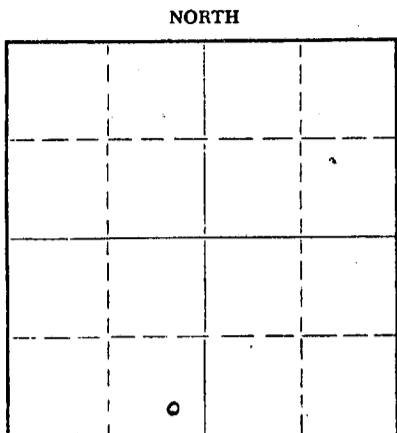

Locate well correctly on above Section Plat

Lane _____ County, Sec. 5 Twp. 17s Rge. (E) 27 (W)
Location as "NE/CNW/SW" or footage from lines SE/4 SE/4 SW/4

Lease Owner Dane G. Hansen Trust

Lease Name Miller 'A' Well No. 2

Office Address P. O. Box 187, Logan, Kansas 67646

Character of Well (completed as Oil, Gas or Dry Hole) Oil

Date well completed May 24 1982

Application for plugging filed May 12 1983

Application for plugging approved May 12 1983

Plugging commenced May 12 1983

Plugging completed May 16 1983

Reason for abandonment of well or producing formation _____

Not economical

If a producing well is abandoned, date of last production October 11, 1982

Was permission obtained from the Conservation Division or its agents before plugging was commenced? Yes

Name of Conservation Agent who supervised plugging of this well Paul Luthi

Producing formation Kansas City Depth to top 3920 Bottom 4239 Total Depth of Well 4560 Feet

Show depth and thickness of all water, oil and gas formations.

OIL, GAS OR WATER RECORDS

CASING RECORD

FORMATION	CONTENT	FROM	TO	SIZE	PUT IN	PULLED OUT
Lansing/K. C.	Oil & Water	G. L.	4262	4 1/2"	4262'	2725'

Describe in detail the manner in which the well was plugged, indicating where the mud fluid was placed and the method or methods used in introducing it into the hole. If cement or other plugs were used, state the character of same and depth placed, from _____ feet to _____ feet for each plug set.

Pumped down through surface casing:

- 1 sx. Hulls
- 5 sx. Gel
- 70 sx. Cement (60/40 Poz.)
- 10 sx. Gel
- 1 sx. Hulls
- Plug (8 5/8" dry hole plug)
- 170 sx. Cement (60/40 Poz.)
- Shut-in with 200# Pressure

(If additional description is necessary, use BACK of this sheet)

Name of Plugging Contractor Allied Cementing Co., Inc.

Address P. O. Box 31, Russell, Kansas 67665

STATE OF KANSAS, COUNTY OF PHILLIPS, ss.

Dane G. Bales, Manager (employee of owner) or (owner or operator) of the above-described

well, being first duly sworn on oath, says: That I have knowledge of the facts, statements, and matters herein contained and the log of the above-described well as filed and that the same are true and correct. So help me God.

(Signature) Dane G. Bales

Logan, Kansas 67646
(Address)

SUBSCRIBED AND SWORN to before me this 3rd day of August, 1983

Betty Jane Bittek
Betty Jane Bittek Notary Public.

My commission expires July 17, 1984.

