


15-101-20410-00-00

STATE OF KANSAS
STATE CORPORATION COMMISSION

WELL PLUGGING RECORD

Give All Information Completely
Make Required Affidavit
Mail or Deliver Report to
Conservation Division
State Corporation Comm.
245 North Water
Wichita, KS 67202

Lane _____ County. Sec. 4 Twp. 17S Rge. 27W E/W
Location as "NE/CNW 1/4 SW 1/4" or footage from lines _____
Appr. C SE SE
Lease Owner Helmerich & Payne, Inc.
Lease Name LEIGHTON "A" Well No. 3
Office Address P.O. Box 558, Garden City, Kansas 67846
Character of Well (Completed as Oil, Gas or Dry Hole) _____
Dry Hole

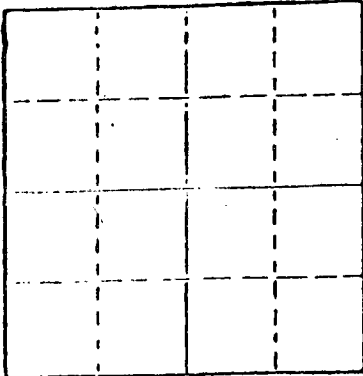

Locate well correctly on above
Section Plat

Date Well completed Nov. 7 1979
Application for plugging filed (verbally) Nov. 7 1979
Application for plugging approved (verbally) Nov. 7 1979
Plugging commenced Nov. 7 1979
Plugging completed Nov. 7 1979
Reason for abandonment of well or producing formation _____
No commercial quantity of oil or gas encountered.
If a producing well is abandoned, date of last production _____
19

Was permission obtained from the Conservation Division or
its agents before plugging was commenced? Yes

Name of Conservation Agent who supervised plugging of this well _____
Producing formation _____ Depth to top _____ Bottom _____ Total Depth of Well 4640'
Show depth and thickness of all water, oil and gas formations.

OIL, GAS OR WATER RECORDS

CASING RECORD

FORMATION	CONTENT	FROM	TO	SIZE	PUT IN	PULLED OUT

Describe in detail the manner in which the well was plugged, indicating where the mud fluid
was placed and the method or methods used in introducing it into the hold. If cement or other
plugs were used, state the character of same and depth placed, from _____ feet to
_____ feet for each plug set.

T.D. 4640'
Set 1st plug at 650' with 70 sacks
2nd plug at 340' with 20 sacks
3rd plug at 40' solid bridge with 10 sacks
rathole with 5 sacks.
Job was complete at 5:30 p.m., 11-07-79.

(If additional description is necessary, use BACK of this sheet)

Name of Plugging Contractor Abercrombie Drilling, Inc.

STATE OF Kansas COUNTY OF Sedgwick, ss.
Jack L. Partridge, Asst. Sec.-Treas. (employee of owner) or (owner or operator)
of the above-described well, being first duly sworn on oath, says: That I have knowledge of
the facts, statements, and matters herein contained and the log of the above-described well
as filed and that the same are true and correct. So help me God.

(Signature) Jack L. Partridge
801 Union Center, Wichita, Kansas
(Address)

SUBSCRIBED AND SWORN TO before me this 20th day of November, 19 79



My commission expires 08-21-82

Sherrie L. Brooks
Sherrie L. Brooks Notary Public.

RECEIVED
STATE CORPORATION COMMISSION

NOV 26 1979

CONSERVATION DIVISION
Wichita, Kansas

15-101-20410-00-00

CONTRACTOR'S WELL LOG

OPERATOR: Helmerich & Payne, Inc.
 CONTRACTOR: Abercrombie Drilling, Inc.
 WELL NAME: Leighton "A" #3
 LOCATION: Approx. C SE SE, Section 4-17S-27W
 Lane County, Kansas
 SPUD DATE: October 27, 1979
 COMPLETION DATE: November 7, 1979

0	489	Sand and shale
489	2040	Shale and sand
2040	2059	Sand and shale
2059	2096	Anhydrite
2096	2492	Sand and shale
2492	3927	Shale and lime
3927	3960	Lime and shale
3960	4123	Lime
4123	4200	Shale and lime
4200	4640	Lime
	4640	Rotary Total Depth

Spud hole at 1:30 p.m., October 27, 1979. Drilled 370' of 12 1/4" hole. Ran 9 joints of 8-5/8" - 23# casing. (Talley 360.81') Set at 369.87' with 210 sacks of 60/40 posmix. Cement did circulate. Plug was down at 8:15 p.m., October 27, 1979.

T.D. 4640'. Set 1st plug at 650' with 70 sacks, 2nd plug at 340' with 20 sacks, 3rd plug at 40' solid bridge with 10 sacks and 5 sacks in the rathole. Job was complete at 5:30 p.m., November 07, 1979.

SAMPLE TOPS:

Anhydrite 2059'
 B/Anhydrite 2096'

STATE OF KANSAS)
) SS
 COUNTY OF SEDGWICK)

RECEIVED
STATE CORPORATION COMMISSION


NOV 26 1979

Jack L. Partridge, Assistant Secretary-Treasurer of Abercrombie Drilling, Inc. does hereby state that the above and foregoing is a true and correct copy of the log of the Leighton "A" #3, Approx. C SE SE, Section 4-17S-27W Lane County, Kansas.

ABERCROMBIE DRILLING, INC.

BY Jack L. Partridge
 Jack L. Partridge
 Assistant Secretary-Treasurer

Subscribed and sworn to before me, a Notary Public, in and for the county and state aforesaid, as of this 20th day of November, 1979.

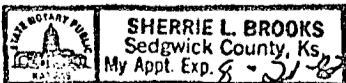

Sherrie L. Brooks
 Sherrie Brooks, Notary Public

My commission expires 08-21-82.