

STATE CORPORATION COMMISSION OF KANSAS
OIL & GAS CONSERVATION DIVISION

WELL COMPLETION OR RECOMPLETION FORM
ACO-1 WELL HISTORY

DESCRIPTION OF WELL AND LEASE

Operator: License # 9641
Name Stauffer Oil & Gas, Inc.
Address P.O. Box 6
City/State/Zip Liberal, KS 67901

Purchaser N/A

Operator Contact Person R. F. Burke
Phone 316-624-3767

Contractor: License # 5104
Name Blue Goose Drilling Co.

Wellsite Geologist Casey Galloway
Phone 316-267-6248

Designate Type of Completion
 New Well Re-Entry Workover
 Oil SWD Temp Abd
 Gas Inj Delayed Comp.
 Dry Other (Core, Water Supply etc.)

If OWWO: old well info as follows:
Operator
Well Name
Comp. Date Old Total Depth

WELL HISTORY

Drilling Method:
 Mud Rotary Air Rotary Cable

..1-18-85.. ..1-25-85.... ..N/A.....
Spud Date Date Reached TD Completion Date
...4665.... ..Surface....
Total Depth PBTD

Amount of Surface Pipe Set and Cemented at 20 feet
Multiple Stage Cementing Collar Used? Yes No
If yes, show depth set.....feet
If alternate 2 completion, cement circulated from.....feet depth to.....w/.....SX cmt

API NO. 15-101-21,120-00-00
County Lane
NW..NW..NW.. Sec.1.. Twp.19S Rge.28... East West


..4950... Ft North from Southeast Corner of Section
..4950... Ft West from Southeast Corner of Section
(Note: Locate well in section plat below)

Lease Name M. Dodge Well #.1

Field Name Wildcat

Producing Formation N/A

Elevation: Ground 2731 KB 2738
Section Plat

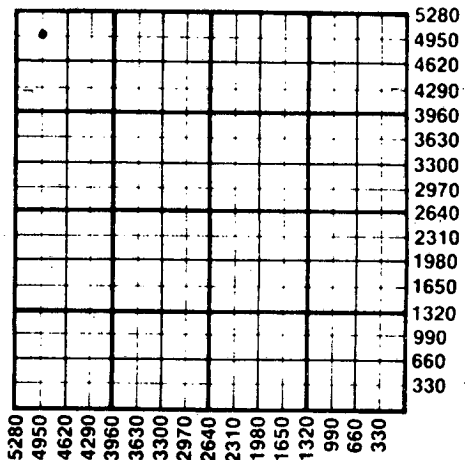

WATER SUPPLY INFORMATION
Disposition of Produced Water: Disposal Repressuring
Docket #

Questions on this portion of the ACO-1 call:
Water Resources Board (913) 296-3717

Source of Water:
Division of Water Resources Permit #

Groundwater.....Ft North from Southeast Corner
.....Ft West from Southeast Corner of
Sec Twp Rge East West
 Surface Water.....Ft North from Southeast Corner
Stream, pond etc).....Ft West from Southeast Corner
Sec Twp Rge East West
 Other (explain). Purchased from Dighton.....
(purchased from city, R.W.D. #)


INSTRUCTIONS: This form shall be completed in duplicate and filed with the Kansas Corporation Commission, 200 Colorado Derby Building, Wichita, Kansas 67202, within 90 days after completion or recompletion of any well. Rule 82-3-130 and 82-3-107 apply.
Information on side two of this form will be held confidential for a period of 12 months if requested in writing and submitted with the form. See rule 82-3-107 for confidentiality in excess of 12 months.
One copy of all wireline logs and drillers time log shall be attached with this form. Submit CP-4 form with all plugged wells. Submit CP-111 form with all temporarily abandoned wells.

All requirements of the statutes, rules and regulations promulgated to regulate the oil and gas industry have been fully complied with and the statements herein are complete and correct to the best of my knowledge.

Signature R. F. Burke
Title Agent Date 2-22-85

Subscribed and sworn to before me this 22 day of February 1985
Notary Public Edna M. Parish

Date Commission Expires

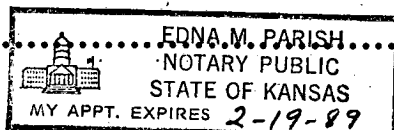

K.C.C. OFFICE USE ONLY
F Letter of Confidentiality Attached
C Wireline Log Received
C Drillers Timelog Received
Distribution
 KCC SWD/Rep NGPA
 KGS Plug Other (Specify)

Sec. 1, Twp. 19, Rge. 28W

SIDE TWO

Operator Name Stauffer Oil & Gas, Inc. Lease Name M. Dodge Well # 1

Sec. 1 Twp. 19S Rge. 28 East West County Lane

WELL LOG

INSTRUCTIONS: Show important tops and base of formations penetrated. Detail all cores. Report all drill stem tests giving interval tested, time tool open and closed, flowing and shut-in pressures, whether shut-in pressure reached static level, hydrostatic pressures, bottom hole temperature, fluid recovery, and flow rates if gas to surface during test. Attach extra sheet if more space is needed. Attach copy of log.

Drill Stem Tests Taken <input checked="" type="checkbox"/> Yes <input type="checkbox"/> No Samples Sent to Geological Survey <input checked="" type="checkbox"/> Yes <input type="checkbox"/> No Cores Taken <input type="checkbox"/> Yes <input checked="" type="checkbox"/> No	Formation Description <input checked="" type="checkbox"/> Log <input type="checkbox"/> Sample	
<table border="0" style="width: 100%;"> <tr> <td style="width: 50%;">DST #1 4260-4300</td> <td style="width: 50%;">DST #2 4300-4338</td> </tr> <tr> <td>15-45-30=60</td> <td>15-45-60-90</td> </tr> <tr> <td>IH 2114</td> <td>IH 2285</td> </tr> <tr> <td>IF 55-55</td> <td>IF 90-135</td> </tr> <tr> <td>ISIP 1113</td> <td>ISIP 1240</td> </tr> <tr> <td>FF 66-66</td> <td>FF 192-294</td> </tr> <tr> <td>FSIP 1113</td> <td>FSIP 1229</td> </tr> <tr> <td>FH 2114</td> <td>FH 2285</td> </tr> <tr> <td>BHT 121^o F</td> <td>BHT 122^o F</td> </tr> <tr> <td>Rec 55' WCM</td> <td>Rec 480' SW</td> </tr> </table>	DST #1 4260-4300	DST #2 4300-4338	15-45-30=60	15-45-60-90	IH 2114	IH 2285	IF 55-55	IF 90-135	ISIP 1113	ISIP 1240	FF 66-66	FF 192-294	FSIP 1113	FSIP 1229	FH 2114	FH 2285	BHT 121 ^o F	BHT 122 ^o F	Rec 55' WCM	Rec 480' SW	<table border="0" style="width: 100%;"> <thead> <tr> <th style="text-align: left;">Name</th> <th style="text-align: left;">Top</th> <th style="text-align: left;">Bottom</th> </tr> </thead> <tbody> <tr> <td>Anhydrite</td> <td>2094</td> <td>2124</td> </tr> <tr> <td>Heebner</td> <td>3950</td> <td>3954</td> </tr> <tr> <td>Lansing</td> <td>3987</td> <td>4260</td> </tr> <tr> <td>Stark</td> <td>4260</td> <td>4264</td> </tr> <tr> <td>B/KC</td> <td>4343</td> <td></td> </tr> <tr> <td>Ft. Scott</td> <td>4516</td> <td>4528</td> </tr> <tr> <td>Cherokee</td> <td>4538</td> <td>4585</td> </tr> <tr> <td>Mississippi</td> <td>4598</td> <td>TD</td> </tr> </tbody> </table>	Name	Top	Bottom	Anhydrite	2094	2124	Heebner	3950	3954	Lansing	3987	4260	Stark	4260	4264	B/KC	4343		Ft. Scott	4516	4528	Cherokee	4538	4585	Mississippi	4598	TD

CASING RECORD <input checked="" type="checkbox"/> New <input type="checkbox"/> Used Report all strings set-conductor, surface, intermediate, production, etc.							
Purpose of String	Size Hole Drilled	Size Casing Set (in O.D.)	Weight Lbs/Ft.	Setting Depth	Type of Cement	#Sacks Used	Type and Percent Additives
Surface	12 1/4"	8 5/8"	24#	261'	Class. H	225	3% CaCl ₂
PERFORATION RECORD N/A				Acid, Fracture, Shot, Cement Squeeze Record			
Shots Per Foot	Specify Footage of Each Interval Perforated			(Amount and Kind of Material Used)		Depth	
TUBING RECORD Size Set At Packer at Liner Run <input type="checkbox"/> Yes <input type="checkbox"/> No							
Date of First Production		Producing Method					
		<input type="checkbox"/> Flowing <input type="checkbox"/> Pumping <input type="checkbox"/> Gas Lift <input type="checkbox"/> Other (explain).....					
Estimated Production Per 24 Hours		Oil	Gas	Water	Gas-Oil Ratio	Gravity	
		Bbls	MCF	Bbls	CFPB		

METHOD OF COMPLETION		Production Interval
Disposition of gas: <input type="checkbox"/> Vented	<input type="checkbox"/> Open Hole	<input type="checkbox"/> Perforation
<input type="checkbox"/> Sold	<input type="checkbox"/> Other (Specify)
<input type="checkbox"/> Used on Lease	<input type="checkbox"/> Dually Completed
	<input checked="" type="checkbox"/> Commingled