


WELL PLUGGING RECORD

Give All Information Completely
Make Required Affidavit
Mail or Deliver Report to:
Conservation Division
State Corporation Commission
211 No. Broadway
Wichita, Kansas

Kerny County. Sec. 20 Twp. 24S Rge. 37W (E) (W)
Location as "NE/CNW/SW" or footage from lines C-SE-SE
Lease Owner Horizon Oil & Gas Co.
Lease Name Krehbiel Well No. 1-20
Office Address P.O. Box 7 Spearman, Texas 79081
Character of Well (completed as Oil, Gas or Dry Hole) Dry Hole
Date well completed 1-29 19 64
Application for plugging filed 1-30 19 64
Application for plugging approved 1-30 19 64
Plugging commenced 1-30 19 64
Plugging completed 1-30 19 64
Reason for abandonment of well or producing formation Dry Hole

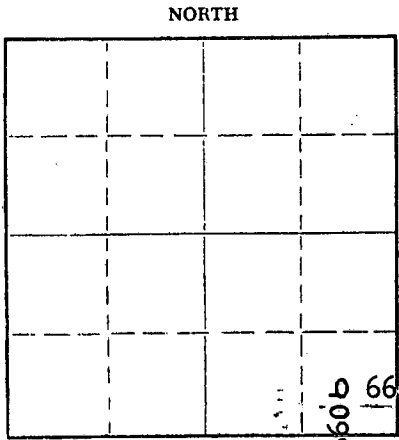

Locate well correctly on above Section Plat

If a producing well is abandoned, date of last production none 19____
Was permission obtained from the Conservation Division or its agents before plugging was commenced? Yes

Name of Conservation Agent who supervised plugging of this well Hugh Scott-----Sublette, Kansas
Producing formation none Depth to top - Bottom - Total Depth of Well 5450 Feet
Show depth and thickness of all water, oil and gas formations.

OIL, GAS OR WATER RECORDS

CASING RECORD

FORMATION	CONTENT	FROM	TO	SIZE	PUT IN	PULLED OUT
	DRY HOLE	Surface	5450	8-5/8"	534'	NONE

Describe in detail the manner in which the well was plugged, indicating where the mud fluid was placed and the method or methods used in introducing it into the hole. If cement or other plugs were used, state the character of same and depth placed, from 500 feet to 40 feet for each plug set.

Mud in hole. Set 35 sack cement plug at base of surface at 500', and 15 sack cement plug at surface at 40'

RECEIVED
STATE CORPORATION COMMISSION

FEB 5 1964

CONSERVATION DIVISION
Wichita, Kansas

(If additional description is necessary, use BACK of this sheet)

Name of Plugging Contractor Halliburton
Address Liberal, Kansas

STATE OF Texas, COUNTY OF Hansford, ss.

Everett R. Tracy (employee of owner) or (~~owner~~) of the above-described well, being first duly sworn on oath, says: That I have knowledge of the facts, statements, and matters herein contained and the log of the above-described well as filed and that the same are true and correct. So help me God.

(Signature) Everett R. Tracy
P.O. Box 7, Spearman, Texas 79081
(Address)

SUBSCRIBED AND SWORN TO before me this 31 day of January, 1964

My commission expires June 1, 1964

Jessie Faries
Hansford County, Texas

Notary Public.

15-093-00055-0000

ROTARY DRILLING LOG

OWNER: Horizon Oil & Gas
CONTRACTOR: Prime Drilling Company
LEASE: Krobbiel #1
LOCATION: C SE SE, Sec. 20-24-37W
Kearney County, Kansas

CASING: Set 8 5/8" surface casing
at 534', 350 sacks HA-5

0 - 500	Shale & Shells
500 - 780	Shale
780 - 1135	Shale & Lime
1135 - 1160	Red Bed & Anhydrite
1160 - 1388	Shale & Lime
1388 - 1570	Sand
1570 - 1655	Sand & Shale
1655 - 1820	Lime & Shale
1820 - 2048	Shale & Lime
2048 - 2343	Shale & Red Bed
2343 - 2427	Shale, Lime & Shells
2427 - 2690	Shale & Lime
2690 - 2808	Lime & Shale
2808 - 2918	Shale & Lime
2918 - 3191	Lime & Shale
3191 - 3217	Lime
3217 - 3305	Lime & Shale
3305 - 3657	Lime
3657 - 3740	Lime & Shale Streaks
3740 - 4225	Lime
4225 - 4314	Lime & Shale
4314 - 4405	Lime
4405 - 4490	Lime & Shale
4490 - 4945	Lime
4945 - 5025	Lime & Shale
5025 - 5078	Shale & Lime
5078 - 5164	Lime & Shale
5164 - 5240	Lime
5240 - 5250	Shale & Lime
5250 - 5305	Lime
5305 - 5340	Lime & Shale
5340 - 5395	Lime
5395 - 5430	Lime & Shale
5430 - 5450	Lime
3450	Rotary Total Depth

RECEIVED
STATE CORPORATION COMMISSION
FEB 10 1964
CONSERVATION DIVISION
Wichita, Kansas

D & A

We certify that the above log is true and correct to the best of our knowledge and belief.

PRIME DRILLING COMPANY



BY *[Signature]*
K. J. CLAMPETT