


Give All Information Completely
Make Required Affidavit
Mail or Deliver Report to:
Conservation Division
State Corporation Commission
P. O. Box 17027
Wichita, Kansas 67217
NORTH

WELL PLUGGING RECORD

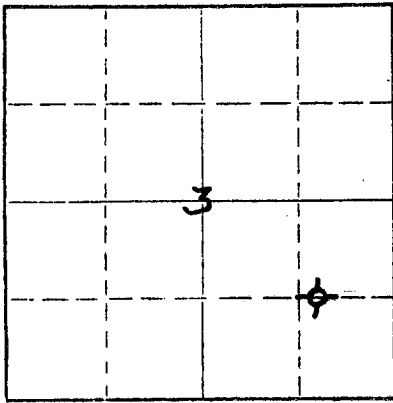

Locate well correctly on above Section Plat

Kearny County, Sec. 3 Twp. 22s Rge. 36w (E) (W)
Location as "NE/CNWSW" or footage from lines 1230 FEL & 1320 FSL
Lease Owner Dare Gas Inc.
Lease Name Flintjer Well No. 1
Office Address Box 544 Liberal, Kansas 67961
Character of Well (completed as Oil, Gas or Dry Hole) Dry Hole
Date well completed 9-3-73 19
Application for plugging filed 9-3-73 19
Application for plugging approved 9-3-73 19
Plugging commenced 9-3-73 19
Plugging completed 9-3-73 19
Reason for abandonment of well or producing formation No productive Formations encountered
If a producing well is abandoned, date of last production none 19
Was permission obtained from the Conservation Division or its agents before plugging was commenced? Permission granted by E. Eves Sublette, Kansas

Name of Conservation Agent who supervised plugging of this well E. Eves
Producing formation none Depth to top _____ Bottom _____ Total Depth of Well 2800 Feet
Show depth and thickness of all water, oil and gas formations.

OIL, GAS OR WATER RECORDS

CASING RECORD

FORMATION	CONTENT	FROM	TO	SIZE	PUT IN	PULLED OUT
Surface sand	none	0	315'	8 5/8"	315'	none
Shale and Anhydrite	none	315'	2665'			
Dolomite and Shale	none	2665'	2800'			

Describe in detail the manner in which the well was plugged, indicating where the mud fluid was placed and the method or methods used in introducing it into the hole. If cement or other plugs were used, state the character of same and depth placed, from _____ feet to _____ feet for each plug set.

35 sx 600' to 500'
35 sx 315' to 215'
15 sx 45' to 0'

RECEIVED
STATE CORPORATION COMMISSION
SEP 5 1973
CONSERVATION DIVISION
Wichita, Kansas

(If additional description is necessary, use BACK of this sheet)


Name of Plugging Contractor Earl F. Wakefield Drilling co.
Address Wichita, Kansas

STATE OF Kansas, COUNTY OF Seward, ss.
Ralph M. Reynolds (employee of owner) or (owner or operator) of the above-described well, being first duly sworn on oath, says: That I have knowledge of the facts, statements, and matters herein contained and the log of the above-described well as filed and that the same are true and correct. So help me God.

(Signature) Ralph M. Reynolds
Box 544 Liberal, Kansas
(Address)

SUBSCRIBED AND SWORN to before me this 4th day of September, 1973

Just J. Tilgner Notary Public.

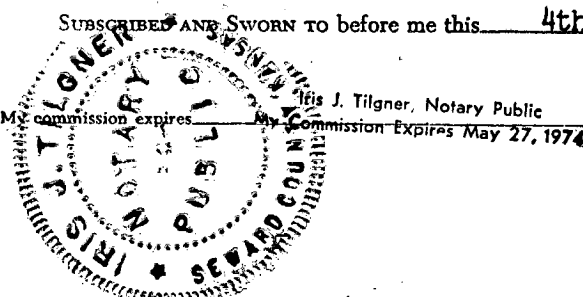

DRILLER'S LOG

LEASE: FLINTGER #1
OWNER: DARE GAS, INC.
CONT: EARL F. WAKEFIELD, INC.
SPUD: 8-30-73
COMP: 9-3-73

LOCATION: C SE/4
SECTION 3-22S-36W
KEARNY COUNTY, KANSAS
CASING: 8 5/8" SET @ 314.65'

Clay & Sand, Blue Shale	316
Shale	1135
Red Bed, Sand, Shale	1809
Shale - Sand	2205
Shale W/Lime	2569
Shale & Lime	2734
Lime	2800
R.T.D.	2800

RECEIVED
STATE CORPORATION COMMISSION
SEP 13 1973
CONSERVATION DIVISION
Wichita, Kansas

STATE OF KANSAS)
) ss.
COUNTY OF SEDGWICK)

I, Gerald L. Mason, do hereby certify that this is a true and correct log on the Flintger #1, located C SE/4 Section 3-27S-36W, Kearny County, Kansas, as shown by the daily drilling reports.

EARL F. WAKEFIELD, INC.

By Gerald L. Mason
Gerald L. Mason

Subscribed and sworn to before me this 7th Day of September, 1973.

My Commission Expires:
October 22, 1974

Carol Jean Noel
Carol Jean Noel - Notary Public

