


STATE OF KANSAS
 STATE CORPORATION COMMISSION
 Give All Information Completely
 Make Required Affidavit
 Mail or Deliver Report to:
 Conservation Division
 State Corporation Commission
 800 Bittig Building
 Wichita, Kansas

15-093-00612.0000

WELL PLUGGING RECORD

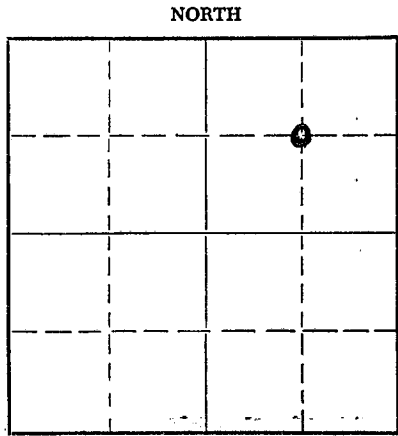

Locate well correctly on above Section Plat

Kearny County. Sec. 1 Twp. 22 Rge. 36 (E) W. (W)
 Location as "NE/CNW/SW" or footage from lines Center of NE/4
 Lease Owner PETROLEUM, Incorporated
 Lease Name MILLER UNIT Well No. 1
 Office Address 311 East Third Street, Wichita 2, Kansas
 Character of Well (completed as Oil, Gas or Dry Hole) Dry Hole
 Date well completed June 13 19 54
 Application for plugging filed August 3 19 54
 Application for plugging approved August 22 19 54
 Plugging commenced August 22 19 54
 Plugging completed August 25 19 54
 Reason for abandonment of well or producing formation No producible shows.

If a producing well is abandoned, date of last production --- 19 ---
 Was permission obtained from the Conservation Division or its agents before plugging was commenced? yes

Name of Conservation Agent who supervised plugging of this well M. A. Rives, Pratt, Kansas
 Producing formation -- Depth to top --- Bottom --- Total Depth of Well 2769.5 Feet
 Show depth and thickness of all water, oil and gas formations.

OIL, GAS OR WATER RECORDS

CASING RECORD

FORMATION	CONTENT	FROM	TO	SIZE	PUT IN	PULLED OUT
Herington	Gas & Water	2,696'	2,714'	8-5/8"	185'	None
Krider	Gas & Water	2,716'	2,730'	5-1/2"	2752'	971'
Winfield	Dry	2,748'	2,769.5'			

Describe in detail the manner in which the well was plugged, indicating where the mud fluid was placed and the method or methods used in introducing it into the hole. If cement or other plugs were used, state the character of same and depth placed, from --- feet to --- feet for each plug set.

(Hole was plugged back to 2,732').

Placed rock bridge from 2,732' to 2,716' and filled hole with 10 sacks cement on top of rock. Mudded up to 420' and placed good bridge of crushed rock from 420' to 413'. Filled hole with 25 sacks cement on top of bridge. Mudded up to 30' placed rock bridge at 30' and cemented hole to base of well cellar with 10 sacks cement.

Name of Plugging Contractor Forbes Casing Pulling Co.
 Address East Tenth Street, Great Bend, Kansas

STATE OF KANSAS, COUNTY OF BARTON, ss.
PAUL B. SHIVEL (employee of owner) or ~~Notary Public~~ of the above-described well, being first duly sworn on oath, says: That I have knowledge of the facts, statements, and matters herein contained and the log of the above-described well as filed and that the same are true and correct. So help me God.

(Signature) Paul B. Shivel
Route 2, Great Bend, Kansas (Address)

SUBSCRIBED AND SWORN TO before me this 31st day of August, 19 54

My commission expires November 21, 1957



Ray E. Anderson Notary Public.

PLUGGING
 FILE SEC-1 T22 R36W
 BOOK PAGE 53 LINE 38

RECEIVED
 CORPORATION COMMISSION
 SEP - 3 1954
 CONSERVATION DIVISION
 Wichita, Kansas

WELL LOG

15-093-00012-0000

COMPANY **Petroleum, Inc.**

SEC. **1** T. **22** R. **36W**

FARM **MILLER UNIT**

NO. **1**

LOC. **G NB**


TOTAL DEPTH **2755**

COUNTY **Kearney County, Kansas**

COMM. **May 17, 1954**

COMP. **May 22, 1954**

CONTRACTOR **Garvey Drilling Company**

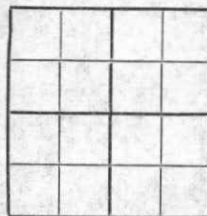

CASING **8-5/8" @ 186 w/175 S&X.**
5 1/2" @ 2752' w/225 S&X.

ELEVATION **3199' DF**

PRODUCTION **Gas**

FIGURES INDICATE BOTTOM OF FORMATIONS

		<u>Tops:</u>
40	Clay	
165	Dry Dakota Gypsum & Post Rock	Harringtons: 2693
185	Blue Shale	Krider: 2716
900	Shale & Shells	Winfield: 2748
1020	Red Rock	
1160	Anhydrite & Red Rock	
1750	Shale & Shells	
1880	Lime, Shale & Pyrite	
2025	Lime & Shale	
2205	Shale & Brown Lime	
2535	Lime & Shale	
2635	Brown Lime	
2755	Lime & Shale	
2755	R.T.D.	

RECEIVED

STATE CORPORATION COMMISSION

SEP - 3 1954

CONSERVATION DIVISION
Wichita, Kansas

State of **KANSAS**

County of **SEDWICK**

SS:

I, **W. V. Fisher**

of

Petroleum, Inc.

upon oath state that the above and foregoing is a true and correct copy of the log of the **MILLER UNIT #1** well.

W. V. Fisher

Subscribed and sworn to before me this **14th** day of **June**, 19 **54**

My Commission Expires: **October 13, 1954**

PLUGGING

FILE SEC **1 T 22 R 36W**
BOOK PAGE **93** LINE **38**

NOTARY PUBLIC

Charlotte Sheedman