

15-093-30067-0000

STATE OF KANSAS
STATE CORPORATION COMMISSION

Form CP-4

WELL PLUGGING RECORD

Give All Information Completely
Make Required Affidavit
Mail or Deliver Report to:
Conservation Division
State Corporation Commission
212 No. Market
Wichita, Kansas

Kearny County. Sec. 30 Twp. 21S Rge. 35W (EX) (W)

Location as "NE/CNWxSWx" or footage from lines C NW NE

Lease Owner The Shallow Water Refining Company

Lease Name Stevens Well No. 1

Office Address Box 11320, Kansas City, Mo.

Character of Well (completed as Oil, Gas or Dry Hole) Dry Hole

Date well completed 11-22-66 19

Application for plugging filed 11-22-66 19

Application for plugging approved 11-22-66 19


Plugging commenced 11-22-66 19

Plugging completed 11-22-66 19

Reason for abandonment of well or producing formation Dry Hole

If a producing well is abandoned, date of last production _____ 19

Was permission obtained from the Conservation Division or its agents before plugging was commenced? yes

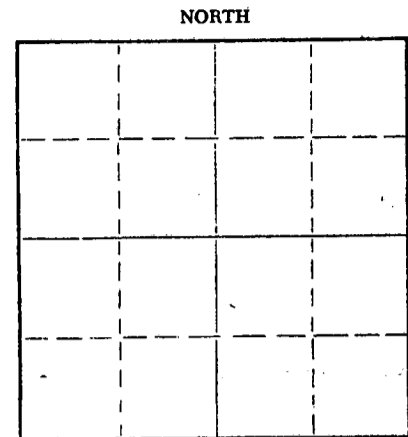

Locate well correctly on above
Section Plat

Name of Conservation Agent who supervised plugging of this well Ed Eaves

Producing formation _____ Depth to top _____ Bottom _____ Total Depth of Well 4690 Feet

Show depth and thickness of all water, oil and gas formations.

OIL, GAS OR WATER RECORDS

CASING RECORD

FORMATION	CONTENT	FROM	TO	SIZE	PUT IN	PULLED OUT
				8 5/8"	425'	none

Describe in detail the manner in which the well was plugged, indicating where the mud fluid was placed and the method or methods used in introducing it into the hole. If cement or other plugs were used, state the character of same and depth placed, from _____ feet to _____ feet for each plug set.

Pushed plug to 425', put in 40 sacks cement through drill pipe
Filled with mud to 40', put in 10 sacks cement

RECEIVED
STATE CORPORATION COMMISSION

DEC 1 1966

CONSERVATION DIVISION
Wichita, Kansas

(If additional description is necessary, use BACK of this sheet)

Name of Plugging Contractor Leben Drilling, Inc.

Address Box 486, Great Bend, Kansas 67530

STATE OF KANSAS, COUNTY OF BARTON, ss. Leslie Kite (employee of owner) or (owner or operator) of the above-described well, being first duly sworn on oath, says: That I have knowledge of the facts, statements, and matters herein contained and the log of the above-described well as filed and that the same are true and correct. So help me God.

(Signature) Leslie Kite

P. O. Box 486, Great Bend, Kansas 67530
(Address)

SUBSCRIBED AND SWORN TO before me this 29th day of November, 1966

My commission expires April 1, 1967

Gloria Spindel
Notary Public.

DRILLER'S LOG

COMPANY: The Shallow Water Refining Co.
 CONTRACTOR: LEBEN DRILLING, INC.
 FARM: STEVENS #1
 LOCATION: C NW NE SEC. 30-21S-35W
 KEARNY COUNTY, KANSAS
 COMMENCED: 11-10-66
 COMPLETED: 11-22-66

0	95	Sand
95	1972	Shale
1972	2507	Shale, Shells
2507	3229	Lime, Shale
3229	3385	Sandy Lime
3385	3965	Lime, Shale
3965	4425	Lime
4425	4470	Lime, Chert
4470	4690	Lime
	<u>4690</u>	<u>RTD - D. & A.</u>

RECEIVED
 STATE CORPORATION COMMISSION
 DEC 1 1966
 CONSERVATION DIVISION
 WICHITA, KANSAS

8 5/8" new 20# surface casing @ 425' cemented with 300 sacks of Common cement, 2% cc


I, Leslie Kite, do hereby certify that the above and foregoing is a true and correct copy of the log of the Stevens #1 Well, located C NW NE of Section 30, Township 21 South, Range 35 West, Kearny County, Kansas, as reflected by the records of Leben Drilling, Inc.

Leslie Kite

Leslie Kite

STATE OF KANSAS)
) SS
 COUNTY OF BARTON)

Subscribed and sworn to and before me, a Notary Public, in and for Barton County, Kansas, this 29th day of November, 1966.

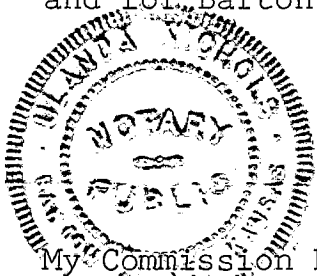

Ulanda Nichols

Ulanda Nichols

My Commission Expires:
 April 1, 1967