

15-093-30064-0000


STATE OF KANSAS
STATE CORPORATION COMMISSION

Form CP-4

WELL PLUGGING RECORD

Give All Information Completely
Make Required Affidavit
Mail or Deliver Report to:
Conservation Division
State Corporation Commission
212 No. Market
Wichita, Kansas

NORTH

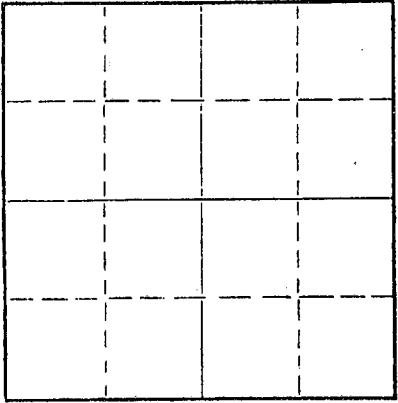

Locate well correctly on above
Section Plat

Kearny County. Sec. 17 Twp. 21S Rge. 35W (E) (W)
Location as "NE/CNW/SW" or footage from lines C NE SW
Lease Owner The Shallow Water Refining Co.
Lease Name Beissel Well No. 1
Office Address P. O. Box 11320, Kansas City, Mo.
Character of Well (completed as Oil, Gas or Dry Hole) Dry Hole
Date well completed 11-9-66 19
Application for plugging filed 11-9-66 19
Application for plugging approved 11-9-66 19
Plugging commenced 11-9-66 19
Plugging completed 11-9-66 19
Reason for abandonment of well or producing formation Dry Hole

If a producing well is abandoned, date of last production _____ 19____
Was permission obtained from the Conservation Division or its agents before plugging was commenced? yes

Name of Conservation Agent who supervised plugging of this well W. L. Nichols for Ed Eaves
Producing formation _____ Depth to top _____ Bottom _____ Total Depth of Well 5146 Feet
Show depth and thickness of all water, oil and gas formations.


OIL, GAS OR WATER RECORDS

CASING RECORD

| FORMATION | CONTENT | FROM | TO | SIZE | PUT IN | PULLED OUT |
|-----------|---------|------|----|--------|--------|------------|
| | | | | 8 5/8" | 418' | none |
| | | | | | | |
| | | | | | | |
| | | | | | | |
| | | | | | | |
| | | | | | | |

Describe in detail the manner in which the well was plugged, indicating where the mud fluid was placed and the method or methods used in introducing it into the hole. If cement or other plugs were used, state the character of same and depth placed, from _____ feet to _____ feet for each plug set.

Plug set @ 660' with 25 sacks cement through drill pipe
Mud to 400' set plug 20 sacks cement
Mud to 40' bridged plug with 1/2 sk. hulls

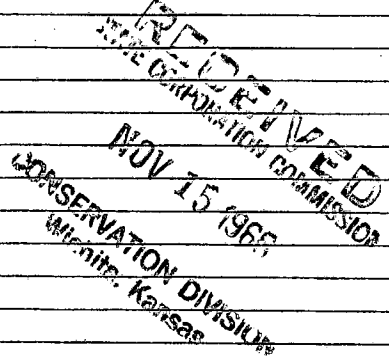


(If additional description is necessary, use BACK of this sheet)

Name of Plugging Contractor Leben Drilling, Inc.
Address P. O. Box 486, Great Bend, Kansas 67530

STATE OF KANSAS, COUNTY OF BARTON, ss.
Leslie Kite (employee of owner) or (owner or operator) of the above-described well, being first duly sworn on oath, says: That I have knowledge of the facts, statements, and matters herein contained and the log of the above described well as filed and that the same are true and correct. So help me God.

(Signature) Leslie Kite
P. O. Box 486, Great Bend, Kansas 67530
(Address)

SUBSCRIBED AND SWORN to before me this 14th day of November, 19 66

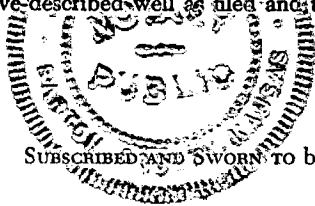

My commission expires April 1, 1967
Ulanda Nichols Notary Public.

15-093-30064-0000

DRILLER'S LOG

COMPANY: Shallow Water Refining Co.
 CONTRACTOR: LEBEN DRILLING, INC.
 FARM: BEISSEL #1
 LOCATION: C NE SW SEC. 17-21S-35W
 KEARNY COUNTY, KANSAS
 COMMENCED: 10-27-66
 COMPLETED: 11-9-66

| | | |
|------|-------------|--------------------------|
| 0 | 35 | Top Soil |
| 35 | 418 | Shale |
| 418 | 524 | Shale, Shells |
| 524 | 1400 | Shale, Redbed |
| 1400 | 1890 | Shale, Shells |
| 1890 | 2130 | Shale |
| 2130 | 2790 | Shale, Lime |
| 2790 | 3280 | Lime, Shale |
| 3280 | 3352 | Lime |
| 3352 | 3510 | Lime, Shale |
| 3510 | 3770 | Shale, Lime |
| 3770 | 3885 | Chalky Shale, Lime |
| 3885 | 4514 | Lime |
| 4514 | 4580 | Lime, Chert Streaks |
| 4580 | 5146 | Lime |
| | <u>5146</u> | <u>RTD - D. & A.</u> |

RECEIVED
 STATE CORPORATION COMMISSION
 NOV 15 1966
 INFORMATION DIVISION
 STATE HOUSE

8 5/8" new 20# surface casing @ 418' with 300 sacks Common, 2% cc

I, Leslie Kite, do hereby certify that the above and foregoing is a true and correct copy of the log of the Beissel #1 Well, located C NE SW of Section 17, Township 21 South, Range 35 West, Kearny County, Kansas, as reflected by the records of Leben Drilling, Inc.

Leslie Kite
 Leslie Kite

STATE OF KANSAS)
) SS
 COUNTY OF BARTON)

Subscribed and sworn to and before me, a Notary Public, in and for Barton County, Kansas, this 14th day of November, 1966.



Ulanda Nichols
 Ulanda Nichols

My Commission Expires:
 April 1, 1967