


WELL PLUGGING RECORD

Give All Information Completely  
Make Required Affidavit  
Mail or Deliver Report to:  
Conservation Division  
State Corporation Commission  
211 No. Broadway  
Wichita, Kansas

NORTH

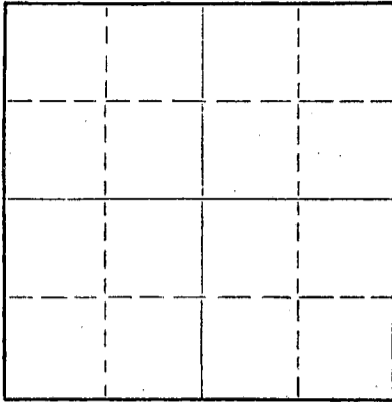

Locate well correctly on above  
Section Plat

Ness County. Sec. 27 Twp. 16 Rge. (E) 25 (W)  
Location as "NE/CNWxSWx" or footage from lines NE NE SW  
Lease Owner Leo J. Dreiling  
Lease Name Burrell Well No. 1  
Office Address Victoria, Kansas  
Character of Well (completed as Oil, Gas or Dry Hole) Oil  
Date well completed \_\_\_\_\_ 19\_\_\_\_  
Application for plugging filed \_\_\_\_\_ 19\_\_\_\_  
Application for plugging approved \_\_\_\_\_ 19\_\_\_\_  
Plugging commenced August 2, \_\_\_\_\_ 1958  
Plugging completed August 5, \_\_\_\_\_ 1958  
Reason for abandonment of well or producing formation well depleted of oil.

If a producing well is abandoned, date of last production \_\_\_\_\_ 19\_\_\_\_  
Was permission obtained from the Conservation Division or its agents before plugging was commenced? yes

Name of Conservation Agent who supervised plugging of this well Gilbert Leiker, Victoria, Kansas  
Producing formation \_\_\_\_\_ Depth to top \_\_\_\_\_ Bottom \_\_\_\_\_ Total Depth of Well \_\_\_\_\_ Feet  
Show depth and thickness of all water, oil and gas formations.

OIL, GAS OR WATER RECORDS

CASING RECORD

FORMATION	CONTENT	FROM	TO	SIZE	PUT IN	PULLED OUT

Describe in detail the manner in which the well was plugged, indicating where the mud fluid was placed and the method or methods used in introducing it into the hole. If cement or other plugs were used, state the character of same and depth placed, from \_\_\_\_\_ feet to \_\_\_\_\_ feet for each plug set.

Plugged back with sand to 4480' and dumped 4 sx. cement. Circulated mud at 600' and spot 20 sx. cement. Pull casing to 260' and spot 20 sx. cement. Pull remainder of casing and set rock bridge at 40'. Dump 10 sx. cement to base of cellar.

RECEIVED  
STATE CORPORATION COMMISSION  
FEB 25 1959  
CONSERVATION DIVISION  
Wichita, Kansas

(If additional description is necessary, use BACK of this sheet)  
Name of Plugging Contractor Ace Pipe Pulling Co.  
Address Box 304, Great Bend, Kansas License # 2

STATE OF KANSAS, COUNTY OF Russell, ss.  
Leo J. Dreiling (employee of owner) or (owner or operator) of the above-described well, being first duly sworn on oath, says: That I have knowledge of the facts, statements, and matters herein contained and the log of the above-described well as filed and that the same are true and correct. So help me God.

(Signature) Leo J. Dreiling  
Victoria, Kansas (Address)

SUBSCRIBED AND SWORN to before me this 5th day of August, 1958

My commission expires July 18, 1961  
Jessie Lee Alumn Notary Public.



PLUGGING  
FILE SEC 27 T 16 R 25W  
BOOK PAGE 117 LINE 41

Bennett & Roberts Oil Operations  
Burrell #1

NE NE SW Sec. 27-16-25  
Ness County, Kansas

E.T.D. 4500'

CONTRACTOR: Bennett & Roberts Drilling Co.

Commenced 5/3/57  
Completed 5/21/57

8 5/8" Set @ 284° w/175 sx ent.  
5 1/2" Set @ 4490° w/125 sx ent.

Surface Soil & Clay	40
Sand	60
Sand & Shale	284
Shale	820
Sand & Shale	910
Shale, Shells & Red Bed	1250
Shale & Shells	1390
Sand	1420
Red Bed	1900
Anhydrite	1945
Shale & Shells	2250
Shale & Lime	2280
Shale & Shells	2515
Shale & Lime	2570
Shale & Lime Streaks	2910
Lime	3060
Shale & Lime	3904
Lime	4302
Lime & Shale	4390
Lime	4490
Cherty Lime	4500

RECEIVED  
STATE CORPORATION COMMISSION

FEB 25 1959

CONSERVATION DIVISION  
Wichita, Kansas

STATE OF KANSAS)  
RUSSELL COUNTY )

I hereby certify that the above information is true and correct  
to the best of my knowledge.

BENNETT & ROBERTS DRILLING CO.

By *Bill Lake*

Subscribed and sworn to before me this 23rd day of May, 1957.

*Wesley L. ...*  
Notary Public

My Commission Expires 6/17/58

PLUGGING

FILE SEC. 27 T. 16 R. 25W  
BOOK PAGE 117 LINE 41

15-135-00121-00-00

# Ace Pipe Pulling Co.

License No. 2

Telephone 3602

Box 304

GREAT BEND, KANSAS

## PLUGGING RECORD

Moved In Aug. 2, 1958

Completed Aug. 5, 1958

Company Leo J. Dreiling

Address Victoria, Kansas

Lease Burrell Well No. 1 Cy. Ness State Kansas

Legal Description NE NE SW Sec. 27 Twp. 16 Rng. 25

Total Depth 4508' Size Pipe 5 1/2" Weight 14# seamless

Casing Cemented At 4490' With 125 Sacks

Size Surface Pipe 8 5/8"

Cemented At 284' With 175 (circ) Sacks

Other Strings

Well Plugged Back To

Top Perforations

Plugging Orders Plugged back with sand to 4480' and dumped 4 sx. cement. Circulate mud at 600' and spot 20 sx. cement. Pull casing to 260' and spot 20 sx. cement. Pull remainder of casing and set rock bridge at 40'. Dump 10 sx. cement to base of cellar.

State Supervisor Gilbert Leiker

Phone Victoria, Kansas

Company Representative Leo J. Dreiling

Phone Rep 5-4111 Victoria, Kansas

**RECEIVED**  
STATE CORPORATION COMMISSION

FEB 25 1959

CONSERVATION DIVISION  
Wichita, Kansas