


STATE OF KANSAS
STATE CORPORATION COMMISSION
Give All Information Completely
Make Required Affidavit
Mail or Deliver Report to:
Conservation Division
State Corporation Commission
211 No. Broadway
Wichita, Kansas

WELL PLUGGING RECORD

Ness County, Sec. 34 Twp. 16S Rge. 25W (E) (W)

Location as "NE/CNW/SW" or footage from lines C-NE-NW
Lease Owner J. M. Huber Corporation
Lease Name Warren Well No. 1
Office Address Box 978, Liberal, Kansas
Character of Well (completed as Oil, Gas or Dry Hole) Dry Hole
Date well completed May 5 1964
Application for plugging filed May 7 1964
Application for plugging approved May 5 1964
Plugging commenced Approx. 1 PM May 5 1964
Plugging completed 6 PM May 5 1964
Reason for abandonment of well or producing formation Dry Hole

NORTH

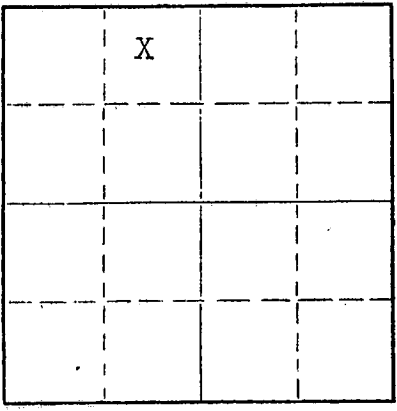

Locate well correctly on above Section Plat

If a producing well is abandoned, date of last production None 19__
Was permission obtained from the Conservation Division or its agents before plugging was commenced? Yes

Name of Conservation Agent who supervised plugging of this well Eldon Petty
Producing formation None Depth to top _____ Bottom _____ Total Depth of Well 1485 Feet
Show depth and thickness of all water, oil and gas formations.

OIL, GAS OR WATER RECORDS

CASING RECORD

FORMATION	CONTENT	FROM	TO	SIZE	PUT IN	PULLED OUT
None				8 5/8"	240'	0

Describe in detail the manner in which the well was plugged, indicating where the mud fluid was placed and the method or methods used in introducing it into the hole. If cement or other plugs were used, state the character of same and depth placed, from _____ feet to _____ feet for each plug set.
Filled hole with mud up to 650'. A 25 sack plug was placed from 650 to 577. Mud to 240'. A 20 sack plug from 240 to 181'. Mud to 40'. At 40' a wooden plug was set, covered with 2 sacks hulls and cemented to surface.

RECEIVED
STATE CORPORATION COMMISSION

MAY 8 1964

CONSERVATION DIVISION
Wichita, Kansas

(If additional description is necessary, use BACK of this sheet)
Name of Plugging Contractor None - Drilling contractor plugged - Gabbert - Jones Inc.
Address Wichita, Kansas

STATE OF Kansas, COUNTY OF Seward, ss.


(employee of owner) or (owner or operator) of the above-described well, being first duly sworn on oath, says: That I have knowledge of the facts, statements, and matters herein contained and the log of the above-described well as filed and that the same are true and correct. So help me God.

(Signature) Harold Jones
Box 978 Liberal Kansas
(Address)

SUBSCRIBED AND SWORN TO before me this 7th day of May 1964

My commission expires March 8, 1967

Mary Kay [Signature]
Notary Public.

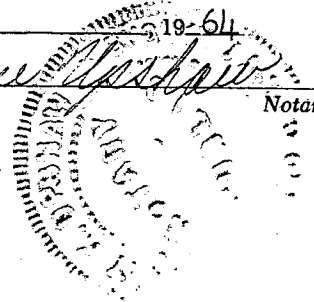

K.G.C.
Wichita

15-135-19074-00-00

GABBERT-JONES INC.
WICHITA, KANSAS
DRILLERS WELL LOG

WARREN #1
C NE NW SECTION 34-16S-25W
NESS COUNTY, KANSAS

COMMENCED: APRIL 23, 1964
COMPLETED: MAY 5, 1964

OPERATOR J. M. HUBER CORPORATION

DEPTH		FORMATION	REMARKS
FROM	TO		
0	120	SAND	
120	240	SHALE & CLAY	
240	610	SHALE	
610	720	SAND & SHALE	
720	1235	SHALE	
1235	1624	SHELLS & SHALE	
1624	1643	LIME & SHALE	
1643	1840	SHALE	
1840	1890	ANHYDRITE	
1890	2575	SHALE & LIME	
2575	2630	LIME	
2630	2848	LIME & SHALE	
2848	2950	LIME	
2950	3180	SHALE & LIME	
3180	3276	LIME	
3276	3870	LIME & SHALE	
3870	4380	LIME	
4380	4450	SHALE & LIME	
4450	4465	CHERTY LIME	
4465	4485	LIME	
4485	TD		DRY & ABANDONED

RAN 7 JOINTS 8-5/8" CASING, SET @
216' W/ 215 SACKS CEMENT
240

I, E. E. HALL, CERTIFY THIS IS A CORRECT COPY OF THE DRILLER'S LOG FOR THE WELL DRILLED IN C NE NW SECTION 34-16S-25W, NESS COUNTY, KANSAS, TO THE BEST OF MY KNOWLEDGE AND BELIEF.



E. E. HALL

STATE OF KANSAS)
) SS
COUNTY OF SEDGWICK)

BEFORE ME, THE UNDERSIGNED, A NOTARY PUBLIC WITHIN AND FOR SAID COUNTY AND STATE, ON THIS 7TH DAY OF MAY, 1964, PERSONALLY APPEARED E. E. HALL TO ME PERSONALLY KNOWN TO BE THE IDENTICAL PERSON WHO EXECUTED THE WITHIN AND FOREGOING INSTRUMENT AND ACKNOWLEDGED TO ME THAT HE EXECUTED THE SAME AS HIS FREE AND VOLUNTARY ACT AND DEED FOR THE USES AND PURPOSES THEREIN SET FORTH.

IN WITNESS WHEREOF, I HAVE HEREUNTO SET MY HAND AND OFFICIAL SEAL THE DAY AND YEAR LAST ABOVE WRITTEN.

My Commission Expires October 2, 1967

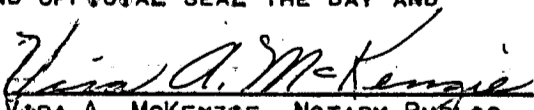
VERA A. MCKENZIE, NOTARY PUBLIC

STATE CORPORATION COMMISSION

MAY 13 1964

CONSERVATION DIVISION
Wichita, Kansas