

15-101-20464-00-00

STATE OF KANSAS
STATE CORPORATION COMMISSION

WELL PLUGGING RECORD

Give All Information Completely
Make Required Affidavit
Mail or Deliver Report to
Conservation Division
State Corporation Comm.
245 North Water
Wichita, KS 67202

LANE _____ County. Sec. 3 Twp. 17 Rge. 27 ~~XX~~W
Location as "NE/CNW $\frac{1}{4}$ SW $\frac{1}{4}$ " or footage from lines
NE NE SW


Lease Owner DANE G HANSEN TRUST
Lease Name BOWLES "B" Well No. 1
Office Address BOX 187, LOGAN, KS 67646
Character of Well (Completed as Oil, Gas or Dry Hole) _____
DRY HOLE

Date Well completed 7/22/80 19
Application for plugging filed 7/22/80 19
Application for plugging approved 7/22/80 19
Plugging commenced 7/22/80 19
Plugging completed 7/22/80 19
Reason for abandonment of well or producing formation _____

Too low structurally
If a producing well is abandoned, date of last production _____ 19

Was permission obtained from the Conservation Division or its agents before plugging was commenced? Yes

Name of Conservation Agent who supervised plugging of this well Gilbert Balthazor
Producing formation _____ Depth to top _____ Bottom _____ Total Depth of Well 4236'
Show depth and thickness of all water, oil and gas formations.

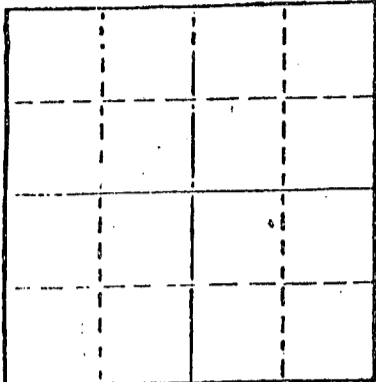

Locate well correctly on above Section Plot

OIL, GAS OR WATER RECORDS

CASING RECORD

FORMATION	CONTENT	FROM	TO	SIZE	PUT IN	PULLED OUT
				8 5/8"	303.92	None

Describe in detail the manner in which the well was plugged, indicating where the mud fluid was placed and the method or methods used in introducing it into the hold. If cement or other plugs were used, state the character of same and depth placed, from _____ feet to _____ feet for each plug set.

FILLED WITH HEAVY MUD TO 750'. SET PLUG. PUT IN 60 SXS CEMENT. FILLED WITH HEAVY MUD TO 300' SET PLUG. PUT IN 30 SXS CEMENT. FILLED WITH HEAVY MUD TO 40'. SET PLUG. FILLED TO TOP WITH 10 SXS CEMENT.

RECEIVED
STATE CORPORATION COMMISSION
AUG 14 1980
CONSERVATION DIVISION
Wichita, Kansas

(If additional description is necessary, use BACK of this sheet)
Name of Plugging Contractor C-G DRILLING CO., INC.

STATE OF KANSAS COUNTY OF SEDGWICK, ss.
G F GALLOWAY (EMPLOYEE) or (owner or operator)

of the above-described well, being first duly sworn on oath, says: That I have knowledge of the facts, statements, and matters herein contained and the log of the above-described well as filed and that the same are true and correct. So help me God.

(Signature) G F Galloway
1107 DOUGLAS BLDG, WICHITA, KS 67202
(Address)

SUBSCRIBED AND SWORN TO before me this 28th day of July, 1980

My commission expires March 3, 1984

Debra L Heersche
Debra L Heersche Notary Public.

KANSAS

WELL COMPLETION REPORT AND
DRILLER'S LOG


API No. 15 — 101 — 20464-00-00
County Number

S. 3 T. 17 R. 27 ^{EX}_W

Loc. NE NE SW

County Lane

640 Acres
N

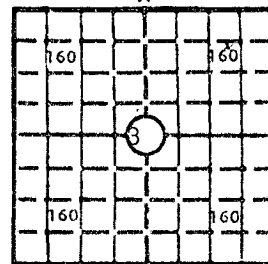

Locate well correctly

Elev.: Gr. _____

DF _____ KB 2625'

Operator
DANE G HANSEN TRUST

Address
P O BOX 187, LOGAN, KS 67646

Well No. 1 Lease Name **BOWLES "B"**

Footage Location
330 feet from (N) ~~XX~~ line 330 feet from (E) ~~XX~~ line

Principal Contractor **C-G DRILLING CO., INC.** Geologist **JERRY JESPERSEN**

Spud Date 7/15/80 Date Completed 7/22/80 Total Depth 4236' P.B.T.D. _____

Directional Deviation _____ Oil and/or Gas Purchaser _____

CASING RECORD

Report of all strings set — surface, intermediate, production, etc.

Purpose of string	Size hole drilled	Size casing set (in O.D.)	Weight lbs./ft.	Setting depth	Type cement	Sacks	Type and percent additives
SURFACE	12 3/4"	8 5/8"	24#	303.92'	COMMON	185	3% Gel 2% CC

LINER RECORD

PERFORATION RECORD

Top, ft.	Bottom, ft.	Sacks cement	Shots per ft.	Size & type	Depth interval

TUBING RECORD

Size	Setting depth	Packer set at

ACID, FRACTURE, SHOT, CEMENT SQUEEZE RECORD

Amount and kind of material used	Depth interval treated

INITIAL PRODUCTION

Date of first production _____ Producing method (flowing, pumping, gas lift, etc.) _____

RATE OF PRODUCTION PER 24 HOURS	Oil	Gas	Water	Gas-oil ratio
	bbls.	MCF	bbls.	CFPB

Disposition of gas (vented, used on lease or sold) _____ Producing interval(s) _____

INSTRUCTIONS: As provided in KCC Rule 82-2-125, within 90 days after completion of a well, one completed copy of this Drillers Log shall be transmitted to the State Geological Survey of Kansas, 4150 Monroe Street, Wichita, Kansas 67209. Copies of this form are available from the Conservation Division, State Corporation Commission, 245 No. Water, Wichita, Kansas 67202. Phone AC 316-522-2206. If confidential custody is desired, please note Rule 82-2-125. Drillers Logs will be on an open file in the Oil and Gas Division, State Geological Survey of Kansas, Lawrence, Kansas 66044.

15-101-20464-00-00

Operator
DANE G HANSEN TRUST

DESIGNATE TYPE OF COMP.: OIL, GAS,
DRY HOLE, SWDW, ETC.:
DRY, HOLE.

Well No. 1 Lease Name BOWLES "B"

S 3 T 17 R 27 W

WELL LOG

Show all important zones of porosity and contents thereof; cored intervals, and all drill-stem tests, including depth interval tested, cushion used, time tool open, flowing and shut-in pressures, and recoveries.

SHOW GEOLOGICAL MARKERS, LOGS RUN, OR OTHER DESCRIPTIVE INFORMATION.

FORMATION DESCRIPTION, CONTENTS, ETC.	TOP	BOTTOM	NAME	DEPTH
HEEBNER	3872	-1247		
TORONTO	3892	-1267		
LANSING	3913	-1288		
STARK	4160	-1535		
B/KC	4229	-1601		
RTD	4236			
<p>DST #1: 4095-4130' 15-45-15-45 REC 5' MUD, IBHP 24#, FBHP 24# IFP 12#, FFP 12#</p> <p>DST #2: 4160-4180' 15-45-15-45 REC 12' MUD, IBHP 617#, FBHP 570# IFP 2424, FFP 36#</p>				

USE ADDITIONAL SHEETS, IF NECESSARY, TO COMPLETE WELL RECORD.

Date Received

Debra Heersche

Signature

Debra Heersche, Office Mgr

Title

8/11/80

Date