

STATE CORPORATION COMMISSION OF KANSAS
OIL & GAS CONSERVATION DIVISION
WELL COMPLETION OR RECOMPLETION FORM
ACO-1 WELL HISTORY
DESCRIPTION OF WELL AND LEASE

Operator: License # 06113
Name Landmark Oil Exploration, Inc.
Address 110 S. Main, Suite 510
City/State/Zip Wichita, Kansas 67202

Purchaser

Operator Contact Person Jeff Wood
Phone (316) 265-8181

Contractor: License # 5883
Name Warrior Drilling Company

Wellsite Geologist Bob O'Dell
Phone (316) 721-2175

Designate Type of Completion
 New Well Re-Entry Workover
 Oil SWD Temp Abd
 Gas Inj Delayed Comp.
 Dry Other (Core, Water Supply etc.)

If OWWO: old well info as follows:
Operator
Well Name
Comp. Date Old Total Depth

WELL HISTORY

Drilling Method:
 Mud Rotary Air Rotary Cable
6-26-87 7-04-87 7-4-87
Spud Date Date Reached TD Completion Date
4670' NA
Total Depth PBTD

Amount of Surface Pipe Set and Cemented at 253 feet
Multiple Stage Cementing Collar Used? Yes No
If yes, show depth set feet
If alternate 2 completion, cement circulated from feet depth to w/SX cmt
Cement Company Name
Invoice #

API NO. 15-101-21,395-00-00
County Lane
NW NW SE Sec. 24 Twp 18S Rge. 28 East West

2310 Ft North from Southeast Corner of Section
4950.230 Ft West from Southeast Corner of Section
(Note: Locate well in section plat below)


Lease Name Parker Well # 1-24

Field Name Wildcat

Producing Formation

Elevation: Ground 2716' KB 2723'

Section Plat

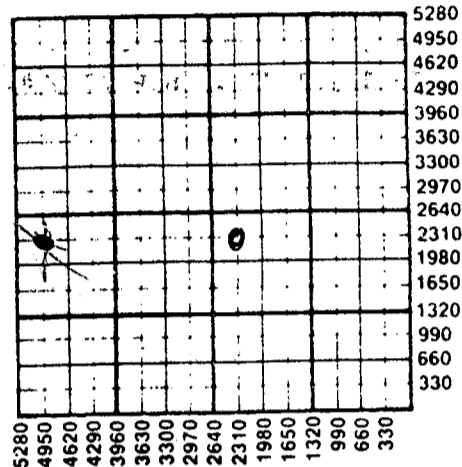

WATER SUPPLY INFORMATION

Disposition of Produced Water: Disposal
Docket # Repressuring

Questions on this portion of the ACO-1 call:
Water Resources Board (913) 296-3717

Source of Water:
Division of Water Resources Permit #
Groundwater Ft North from Southeast Corner (Well) Ft West from Southeast Corner of Sec Twp Rge East West
Surface Water Ft North from Southeast Corner (Stream, pond etc) Ft West from Southeast Corner Sec Twp Rge East West
Other (explain) (purchased from city, R.W.D. #)

INSTRUCTIONS: This form shall be completed in triplicate and filed with the Kansas Corporation Commission, 200 Colorado Derby Building, Wichita, Kansas 67202, within 120 days of the spud date of any well. Rule 82-3-130, 82-3-107 and 82-3-106 apply. Information on side two of this form will be held confidential for a period of 12 months if requested in writing and submitted with the form. See rule 82-3-107 for confidentiality in excess of 12 months. One copy of all wireline logs and drillers time log shall be attached with this form. Submit CP-4 form with all plugged wells. Submit CP-111 form with all temporarily abandoned wells.

All requirements of the statutes, rules and regulations promulgated to regulate the oil and gas industry have been fully complied with and the statements herein are complete and correct to the best of my knowledge.

Signature Jeffrey R. Wood
Title President Date 7-17-87

Subscribed and sworn to before me this 10 day of August 1987
Notary Public Dorothy J. Davis

Date Commission Expires DOROTHY J. DAVIS
NOTARY PUBLIC
STATE OF KANSAS
My Appt. Exp. 8-20-90

K.C.C. OFFICE USE ONLY
 Letter of Confidentiality Attached
 Wireline Log Received
 Drillers Timelog Received
Distribution
 KCC SWD/Rep NGPA
 KGS Plug Other
(Specify)

Sec 24 Twp 18 Rge 28 E

Operator Name Landmark Oil Exploration, Inc. Lease Name Parker Well # 1-24

Sec 24 Twp 18-S Rge 28 East West County Lane

WELL LOG

INSTRUCTIONS: Show important tops and base of formations penetrated. Detail all cores. Report all drill stem tests giving interval tested, time tool open and closed, flowing and shut-in pressures, whether shut-in pressure reached static level, hydrostatic pressures, bottom hole temperature, fluid recovery, and flow rates if gas to surface during test. Attach extra sheet if more space is needed. Attach copy of log.

Drill Stem Tests Taken [X] Yes [] No
Samples Sent to Geological Survey [] Yes [X] No
Cores Taken [] Yes [X] No

Formation Description [X] Log [] Sample

DST #1 4558'-4617', 30-30-30-30. Rec. 5' mud.
FP 31-41#/31-41#. SIP 72-52#.

Table with 3 columns: Name, Top, Bottom. Rows include Anhydrite, Heebner, Lansing, Stark, BKC, Ft. Scott, Cherokee, Mississippi, L.T.D.

RELEASED

SEP 22 1988

FROM CONFIDENTIAL

CASING RECORD, PERFORATION RECORD, TUBING RECORD, Date of First Production, Producing Method, Estimated Production Per 24 Hours

METHOD OF COMPLETION

Production Interval

Disposition of gas: [] Vented [] Sold [] Used on Lease
[] Open Hole [] Perforation [] Other (Specify)
[] Dually Completed [] Commingled

15-101-21395-00-00

DRILLERS LOG

July 6, 1987

PARKER #1-24
NW NW SE Sec. 24-18S-28W
Lane County, Kansas

OPERATOR: Landmark Oil Exploration, Inc.
CONTRACTOR: Warrior Drilling Co.
COMMENCED: 6-26-87
COMPLETED: 7-04-87

8 5/8" 6 jts. @ 253' w/160 sks 60/40

0	85	Surface Clay
85	465	Sand & Clay
465	1840	Sand & Shale
1840	2033	Shale
2033	2114	Anhydrite
2114	3925	Shale
3925	4210	Shale & Lime
4210	4368	Lime & Shale
4368	4670	Lime
	4670	RTD

RELEASED

SEP 22 1988

FROM CONFIDENTIAL

D & A

AUG 25 1987


KANSAS GEOLOGICAL SURVEY
WICHITA BRANCH

We certify that the above and foregoing is a true and correct copy of the log on the #1-24 Parker located in Lane County, Ks.

WARRIOR DRILLING COMPANY

F.W. Shelton, Jr.

F.W. Shelton, Jr.,

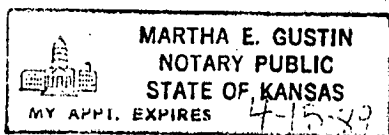

Subscribed and sworn to before me this 6th day of July, 1987

Martha E. Gustin

Martha E. Gustin, Notary Public