

TYPE

AFFIDAVIT OF COMPLETION FORM

ACO-1 WELL HISTORY

SIDE ONE

Two (2) copies of this form shall be filed with the Kansas Corporation Commission, 200 Colorado Derby Building, Wichita, Kansas 67202, within thirty (30) days after the completion of a well, regardless of how the well was completed.

F Attach separate letter of request if the information is to be held confidential. If confidential, only file one copy. Information on Side One will be of public record and Side Two will then be held confidential.

Applications must be made on dual completion, commingling, salt water disposal, injection and temporarily abandoned wells.

C Attach one copy only wireline logs (i.e. electrical log, sonic log, gamma ray neutron log, etc.). (Rules 82-2-105 & 82-2-125) KCC# (316) 263-3238.

LICENSE # 5422 EXPIRATION DATE 6/85

OPERATOR Abercrombie Drilling, Inc.

API NO. 15-101-20,925 - 00-00

ADDRESS 801 Union Center
Wichita, KS 67202

COUNTY Lane

FIELD - -

** CONTACT PERSON Jack L. Partridge
PHONE 316-262-1841

PROD. FORMATION - -

PURCHASER None

LEASE BRETZ

ADDRESS

WELL NO. 1

DRILLING Abercrombie Drilling, Inc.

WELL LOCATION N/2 N/2 SW/4

CONTRACTOR ADDRESS 801 Union Center
Wichita, KS 67202

2310 Ft. from South Line and


1320 Ft. from West Line of

the SW (Qtr.) SEC 4 TWP 18S RGE 28W

PLUGGING Abercrombie Drilling, Inc.

CONTRACTOR ADDRESS 801 Union Center
Wichita, KS 67202

WELL PLAT

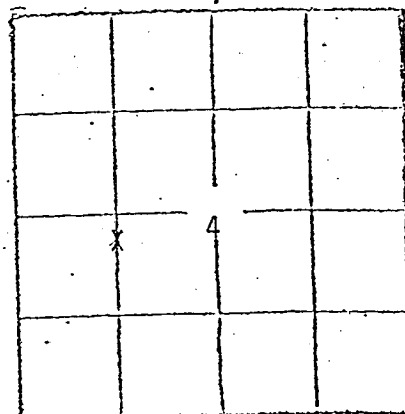

(Office Use Only)

KCC ☒

KGS ☒

SWD/REP

PLG.

TOTAL DEPTH 4610' PBTDX

SPUD DATE 2/23/84 DATE COMPLETED 3/3/84

ELEV: GR 2696' DF 2699' KB 2701'

DRILLED WITH (CABLE) (ROTARY) (AIR) TOOLS.

DOCKET NO. OF DISPOSAL OR REPRESSURING WELL BEING USED TO DISPOSE OF WATER FROM THIS LEASE NONE

Amount of surface pipe set and cemented 305.98' DV Tool Used? YES

THIS AFFIDAVIT APPLIES TO: (Circle ONE) - Oil, Gas, Shut-in Gas, (Dry) Disposal, Injection, Temporarily Abandoned, OWWO. Other

ALL REQUIREMENTS OF THE STATUTES, RULES AND REGULATIONS PROMULGATED TO REGULATE THE OIL AND GAS INDUSTRY HAVE BEEN FULLY COMPLIED WITH.

AFFIDAVIT

Jack L. Partridge, Vice President

, being of lawful age, hereby certifies

that:

I am the Affiant, and I am familiar with the contents of the foregoing Affidavit. The statements and allegations contained therein are true and correct.

Jack L. Partridge, Vice Pres.

SUBSCRIBED AND SWORN TO BEFORE ME this 14th day of March

19 84.


MY COMMISSION EXPIRES:

7-13-85

RECEIVED
STATE CORPORATION COMMISSION
MAR 21 1984
CONSERVATION DIVISION
Wichita, Kansas

Elizabeth G. Terry

** The person who can be reached by phone regarding any questions information.

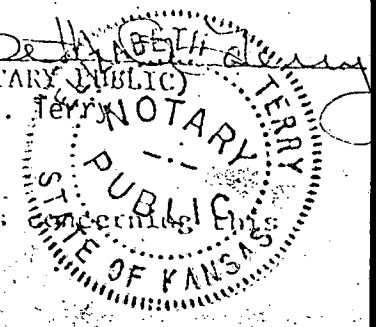

SEC. 4 TWP. 18S RGE. 28W

FILL IN WELL INFORMATION AS REQUIRED:

SHOW GEOLOGICAL MARKERS, LOGS, ETC.,
OR OTHER DESCRIPTIVE INFORMATION.

Show all important zones of porosity and contents thereof; cored intervals, and all distinct tests, including depth interval tested, cushion used, time test open, flowing and shut-in pressures, and intervals.

DATE	LOG	EDITION

[illegible]

LINEER RECORD

PERFORATION RECORD

TUBING RECORD

ACID, FRACTURE, SHOT, CEMENT SQUEEZE RECORD

Unit of first production

Producing method (flaming, pumping, gas lift, etc.)

Gravity

Production -I.P.

City

62

Water

6

•

620.01 12113

CSPS

Disposition of gas invented, used in lease or sold:

Perforations: