

Give All Information Completely  
Make Required Affidavit  
Mail or Deliver Report to:  
Conservation Division  
State Corporation Commission  
211 No. Broadway  
Wichita, Kansas

WELL PLUGGING RECORD

Ness County. Sec. 32 Twp. 16S Rge. (E) 21 (W)

Location as "NE/CNW%SW%" or footage from lines C NE NE

Lease Owner Mull Drilling Company, Inc.

Lease Name IRVIN Well No. 1

Office Address 1625 Wichita Plaza, Wichita, Kansas 67202

Character of Well (completed as Oil, Gas or Dry Hole) Dry Hole

Date well completed August 31 19.65

Application for plugging filed August 31 19.65

Application for plugging approved August 31 19.65


Plugging commenced August 31 19.65

Plugging completed August 31 19.65

Reason for abandonment of well or producing formation No oil or gas found in commercial quantities.

If a producing well is abandoned, date of last production - - 19

Was permission obtained from the Conservation Division or its agents before plugging was commenced? Yes

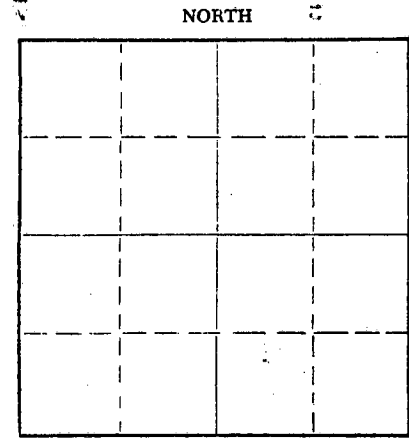

Locate well correctly on above Section Plat

Name of Conservation Agent who supervised plugging of this well Eldon Petty, Hays, Kansas

Producing formation Depth to top Bottom Total Depth of Well 4310 Feet

Show depth and thickness of all water, oil and gas formations.

OIL, GAS OR WATER RECORDS

CASING RECORD

FORMATION	CONTENT	FROM	TO	SIZE	PUT IN	PULLED OUT
				8-5/8"	273'	None

Describe in detail the manner in which the well was plugged, indicating where the mud fluid was placed and the method or methods used in introducing it into the hole. If cement or other plugs were used, state the character of same and depth placed, from feet to feet for each plug set.

Set plug at 540', spotted with 20 sacks cement, mud back to 240', spotted with 20 sacks, mud back to 40', set solid bridge, capped with 10 sacks cement. Plugging completed 2:15 a.m. 8-31-65.

RECEIVED  
STATE CORPORATION COMMISSION  
SEP 7 1965  
09-07-1965  
CONSERVATION DIVISION  
Wichita, Kansas

(If additional description is necessary, use BACK of this sheet)

Name of Plugging Contractor Rains & Williamson Oil Co.

Address 1425 Wichita Plaza, Wichita, Kansas

STATE OF KANSAS, COUNTY OF SEDGWICK, ss.

Wilson Rains (employee of owner) or (owner or operator) of the above-described well, being first duly sworn on oath, says: That I have knowledge of the facts, statements, and matters herein contained and the log of the above-described well as filed and that the same are true and correct. So help me God.


(Signature) Wilson Rains

1425 Wichita Plaza, Wichita, Kansas (Address)

Subscribed and sworn to before me this 2nd day of September, 1965

My commission expires January 8, 1968

Shirley Keck Notary Public.

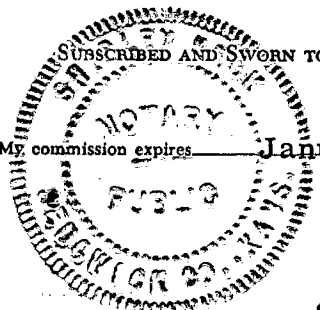

15-135-30154-00-00

ROTARY DRILLING LOG

OPERATOR: Mull Drilling Company, Inc.  
#1 IRVIN  
C NE NE Section 32-16S-21W  
Ness County, Kansas

CONTRACTOR: Rains & Williamson  
Oil Co.

COMMENCED: 8-22-65  
COMPLETED: 8-31-65

REMARKS: Set 273' of 8-5/8"  
surface casing with 175  
sacks GL3 cement.

FORMATIONS:

Surface Clay	40'
Shale	1030'
Sand	1250'
Shale	1572'
Anhydrite	1620'
Shale	2050'
Shale & Shells	2222'
Shale & Lime	2500'
Lime & Shale	3365'
Lime	3593'
Lime & Shale	3680'
Lime	4310'
Rotary Total Depth (D&A)	4310'

RECEIVED  
STATE CORPORATION COMMISSION

SEP 7 1965  
09-07-1965  
CONSERVATION DIVISION  
Wichita, Kansas

We certify the above log is true  
and correct to the best of our  
knowledge and belief.

RAINS & WILLIAMSON OIL CO.

*Wilson Rains*  
Wilson Rains, Partner

Subscribed and sworn to before me, a Notary Public in and for the State  
of Kansas, County of Sedgwick, this 2nd day of September, 1965.

My Commission Expires:  
January 1, 1968

*Shirley Keck*  
Shirley Keck, Notary Public

