


STATE OF KANSAS
STATE CORPORATION COMMISSION
200 Colorado Derby Bldg.
Wichita, Kansas 67202

Form CP-4
Rev. 12-15-80

WELL PLUGGING RECORD

Give All Information Completely
Make Required Affidavit

COUNTY Ness SEC. 30 TWP. 16S RGE. 21 XE/W
Location as in quarters or footage from lines:
SE SW NE

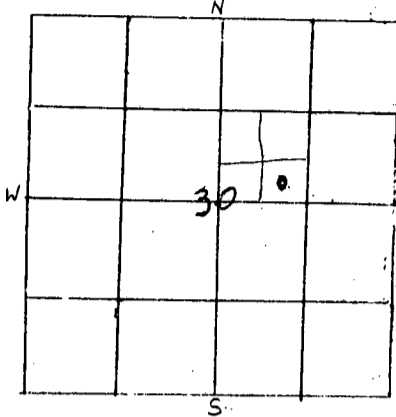

Locate Well
correctly on above
Section Platt.

Lease Owner A. Scott Ritchie # 5198
Lease Name McCurdy Well No. 1
Office Address 125 N. Market Suite 950 Wichita, KS 67202
Character of Well (Completed as Oil, Gas or Dry Hole): Dry Hole
Date Well Completed 6-4-83
Application for plugging filed 6-4-83
Plugging commenced 6-4-83
Plugging completed 6-4-83
Reason for abandonment of well or producing formation DRY HOLE

Was permission obtained from the Conservation Division or it's
Agent's before plugging was commenced? YES

Name of Conservation Agent who supervised plugging of this well Don Ubel
Producing formation _____ Depth to top _____ bottom _____ T.D. 4330'

Show depth and thickness of all water, oil and gas formations.

OIL, GAS OR WATER RECORDS

Casing Record

Formation	Content	From	To	Size	Put in	Pulled Out
		0	269	8 5/8	266	0

Describe in detail the manner in which the well was plugged, indicating where the mud fluid was placed and the method or methods used in introducing it into the hold. If cement or other plugs were used, state the character of same and depth placed, from _____ feet to _____ feet for each plug set.

4330' T.D. 165 Sacks 60-40 Posmix 3% cc 2% gel
Bottom Plug at 1590' with 50 Sacks
2nd Plug at 810' with 50 Sacks
3rd Plug at 300' with 40 Sacks
Solid Bridge @ 40' with 10 Sacks
Circulated 15 Sacks thru jointed pipe in Rathole
Plug down 9:30 P.M. 6-4-83

(If additional description is necessary, use BACK of this sheet)

Name of Plugging Contractor Blue Goose Drilling Co., Inc. # 5104

STATE OF KANSAS COUNTY OF BARTON, ss.
George E. Miller, Jr. (~~employee of owner~~) or (owner or operator) of the


above-described well, being first duly sworn on oath, says: That I have knowledge of the facts, statements, and matters herein contained and the log of the above-described well as filed and that the same are true and correct. So help me God.

(Signature) George E. Miller, Jr.
P.O. Box 1413 Great Bend, KS 67530
(Address)

SUBSCRIBED AND SWORN TO before me this 7th day of June, 19 83

Helen C. Standley RECEIVED
Notary Public. STATE CORPORATION COMMISSION

My Commission expires: 12-8-83

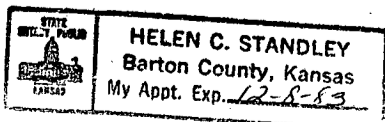

JUL 21 1983
07-21-1983
CONSERVATION DIVISION
Wichita, Kansas

15-135-22391-00-00

WELL LOG

MC Curdy # 1
SE SW NE Sec 30-16S-21W
Ness County, Kansas

NAME OF OPERATOR: A. Scott Ritchie # 5198
125 North Market Suite 950
Wichita, KS 67530

DATE COMPLETED: 6-4-83

FROM	TO	
0	269	Post Rock & Shale
269	2236	Sand and Shale
2236	4330	Shale and Lime
4330		T.D.

STATE OF KANSAS

COUNTY OF BARTON ss

George E. Miller, Jr., President of Blue Goose Drilling Co., Inc. # 5104, being first duly sworn on oath says: That I have knowledge of the facts, statements and matters herein contained and the log of the above described well as filed and that the same are true and correct.

George E. Miller, Jr.
George E. Miller, Jr.

Subscribed and sworn before me this 7th Day of June 1983.

RECEIVED
STATE CORPORATION COMMISSION

07-21-1983
JUL 21 1983

CONSERVATION DIVISION
Wichita, Kansas

Helen C. Standley
Helen C. Standley, Notary Public

My Commission Expires: 12-8-83

STATE NOTARY PUBLIC
HELEN C. STANDLEY
Barton County, Kansas
My Appt. Exp. 12-8-83