


STATE OF KANSAS  
STATE CORPORATION COMMISSION

WELL PLUGGING RECORD

Give All Information Completely  
Make Required Affidavit  
Mail or Deliver Report to  
Conservation Division  
State Corporation Comm.  
245 North Water  
Wichita, KS 67202

Ness County. Sec. 22 Twp. 16S Rge. 24 W  
Location as "NE/CNW $\frac{1}{4}$ SW $\frac{1}{4}$ " or footage from lines  
75' E of C SE SW

Lease Owner Pendleton Land & Exploration, Inc.  
Lease Name Anderson Well No. #1  
Office Address 1410 Security Life Bldg., Denver, Colorado 80202  
Character of Well (Completed as Oil, Gas or Dry Hole)

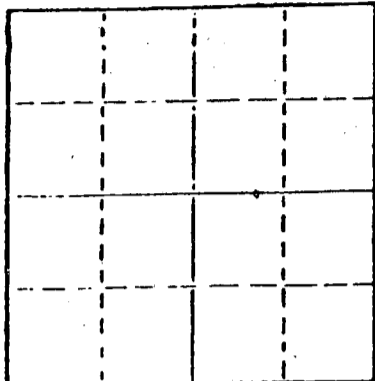

Locate well correctly on above  
Section Plat

Dry Hole  
Date Well completed 3-18-79 19  
Application for plugging filed 3-18-79 19  
Application for plugging approved 3-18-79 19  
Plugging commenced 3-18-79 19  
Plugging completed 3-18-79 19

Reason for abandonment of well or producing formation  
Commercial quantities of oil not found  
If a producing well is abandoned, date of last production 19

Was permission obtained from the Conservation Division or  
its agents before plugging was commenced? Yes

Name of Conservation Agent who supervised plugging of this well Leo Massey, Hays, Kansas  
Producing formation \_\_\_\_\_ Depth to top \_\_\_\_\_ Bottom \_\_\_\_\_ Total Depth of Well 4622'  
Show depth and thickness of all water, oil and gas formations.

OIL, GAS OR WATER RECORDS

CASING RECORD

FORMATION	CONTENT	FROM	TO	SIZE	PUT IN	PULLED OUT
				8 5/8"	292'	None

Describe in detail the manner in which the well was plugged, indicating where the mud fluid was placed and the method or methods used in introducing it into the hold. If cement or other plugs were used, state the character of same and depth placed, from \_\_\_\_\_ feet to \_\_\_\_\_ feet for each plug set.

Plug @ 720' w/70 sx.  
Plug @ 240' w/20 sx.  
Plug @ 40' w/10 sx.  
Rat Hole 2 sx.

RECEIVED  
STATE CORPORATION COMMISSION

JUL 25 1979  
07-23-1979  
CONSERVATION DIVISION  
Wichita, Kansas

(If additional description is necessary, use BACK of this sheet)

Name of Plugging Contractor Rains & Williamson Oil Co., Inc.

STATE OF Kansas COUNTY OF Sedgwick, ss.  
Wilson Rains, President of Rains & Williamson Oil Co., Inc. (employee of owner) or (owner or operator) of the above-described well, being first duly sworn on oath, says: That I have knowledge of the facts, statements, and matters herein contained and the log of the above-described well as filed and that the same are true and correct. So help me God.

(Signature) Wilson Rains  
435 Page Court, 220 W. Douglas, Wichita, Ks. 67202  
(Address)

SUBSCRIBED AND SWORN TO before me this 22 day of March, 1979

Juanita M. Green  
Juanita M. Green Notary Public.

My commission expires \_\_\_\_\_



15-135-21596-00-00

DRILLER'S LOG

COMPANY: Pendleton Land & Exploration, Inc.

SEC. 22 T. 16S R. 24W

WELL NAME: Anderson #1

LOC. 75' E of C SE SW

COUNTY: Ness

RIG NO. #1

TOTAL DEPTH 4622'

ELEVATION

COMMENCED: 3-8-79

COMPLETED: 3-18-79

CONTRACTOR: Rains & Williamson Oil Co., Inc.

CASING RECORD:

SURFACE: 8 5/8" @ 292' w/185 sx. 60/40 poz., 2% gel, 3% cc.

PRODUCTION: D&A

LOG

(Figures Indicate Bottom of Formations)

Shale	1241
Shale & Sand	3672
Shale & Lime	4250
Lime & Shale	4532
Shale & Lime	4552
Lime & Shale	4622
<u>ROTARY TOTAL DEPTH</u>	<u>4622</u>

RECEIVED  
STATE CORPORATION COMMISSION

JUL 23 1979  
07-23-1979  
CONSERVATION DIVISION  
Wichita, Kansas

STATE OF Kansas )  
COUNTY OF Sedgwick ) SS:

I, Wilson Rains, President of Rains & Williamson Oil Co., Inc.  
upon oath state that the above and foregoing is a true and correct copy of the log of the  
Anderson #1 well.

Wilson Rains  
Wilson Rains

Subscribed and sworn to before me this 22 day of March, 1979.

My Appointment  **JUANITA M. GREEN**  
STATE NOTARY PUBLIC  
Sedgwick County, Kansas  
My Appt. Exp. 10/4/79

Juanita M. Green  
Juanita M. Green