

WELL PLUGGING RECORD

Give All Information Completely
Make Required Affidavit
Mail or Deliver Report to:
Conservation Division
State Corporation Commission
800 Bittling Building
Wichita, Kansas

Ness County, Sec. 22 Twp. 16 Rge. 24 (E) (W)

Location as "NE/CNW/SW" or footage from lines NE NE SE

Lease Owner Welch & Olsson Drilling Company, Inc.

Lease Name Miner Well No. 1

Office Address 203 Rule Bldg. Wichita, Kansas

Character of Well (completed as Oil, Gas or Dry Hole) D & A

Date well completed 11-11 19 55

Application for plugging filed 11-11 19 55

Application for plugging approved 11-11 19 55


Plugging commenced 11-11 19 55

Plugging completed 11-11 19 55

Reason for abandonment of well or producing formation D & A

If a producing well is abandoned, date of last production none 19

Was permission obtained from the Conservation Division or its agents before plugging was commenced? Yes

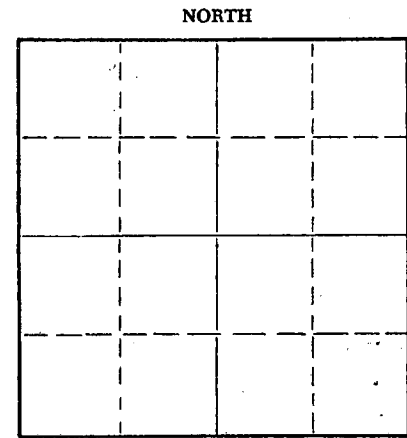

Locate well correctly on above Section Plat

Name of Conservation Agent who supervised plugging of this well Warren H. Horner, Box 207, Great Bend, Ks.

Producing formation Depth to top Bottom Total Depth of Well 4585' Feet

Show depth and thickness of all water, oil and gas formations.

OIL, GAS OR WATER RECORDS

CASING RECORD

FORMATION	CONTENT	FROM	TO	SIZE	PUT IN	PULLED OUT
				8 5/8	224'	None

Describe in detail the manner in which the well was plugged, indicating where the mud fluid was placed and the method or methods used in introducing it into the hole. If cement or other plugs were used, state the character of same and depth placed, from feet to feet for each plug set.

Mudded to 200'. Added 1/4th sacks of hulls. Cemented with 20 sacks of cement thru drill pipe. Plug set at 30'. Added 1/4th sacks of hulls and cemented with 10 sacks of cement.

(If additional description is necessary, use BACK of this sheet)

Name of Plugging Contractor Welch & Olsson Drilling Company, Inc.

Address 203 Rule Bldg. Wichita, Kansas.

STATE OF Kansas, COUNTY OF Sedgwick, ss. R. E. Welch (employee or owner) of the above-described well, being first duly sworn on oath, says: That I have knowledge of the facts, statements, and matters herein contained and the log of the above-described well as filed and that the same are true and correct. So help me God.

(Signature) [Signature] 203 Rule Bldg. Wichita, Kansas (Address)

SUBSCRIBED AND SWORN to before me this 17th day of November, 19 55

My commission expires June 12, 1959



Edith Erker Notary Public.

RECEIVED STATE CORPORATION COMMISSION

NOV 25 1955 11-25-1955 CONSERVATION DIVISION

PLUGGING 28 SEC 22 T 16 R 24 W PAGE 16 LINE 39

15-135 - 00081-00-00

WELL LOG.

WELCH & OLSSON DRILLING COMPANY, INC.
CONTRACTOR: Welch & Olsson Drilling Co. Inc.
MINER #1
NE NE SE Sec. 22-16-24W,
Ness County, Kansas.

Elevation: 2482 R.B.
Commenced Drlg: 10-29-55
Compl. Drlg: 11-11-55
Production: D & A

Casing Record.

Set 224' of 8 5/8" with 175 sacks of cement.

(Figures indicate bottom of formations.)

<u>FORMATIONS:</u>	<u>DEPTHS</u>	<u>FORMATION TOPS.</u>
Sand & Shale:	50	Heebner: 3845 (-1363)
Shale:	215	Toronto: 3863 (-1381)
Shale & Clay:	710	Lansing-Kas. City: 3885 (-1403)
Shale with sand strks:	830	Base Kans. City: 4177 (-1695)
Shale:	880	Fort Scott: 4378 (-1896)
Sand:	980	Cherokee: 4448 (-1966)
Shale & Sand Strks:	1050	Mississippian: 4482 (-2000)
Shale:	1180	
Anhydrite:	1195	
Shale & Red Bed:	1790	
Shale & Shells:	2260	
Shale & Lime:	2510	
Lime & Shale:	2740	
Shale & Lime:	3865	
Lime & Shale:	3930	
Lime:	4175	
Lime & Shale:	4460	
Coring:	4477	
Sand:	4585 T.D.	

STATE OF KANSAS,)
) SS:
SEDGWICK COUNTY,)

I hereby certify that the above is a true and correct copy of Drillers Log of well drilled in the NE NE SE of Sec. 22, Twp. 16, Rge. 24W, Ness County, Kansas.

WELCH & OLSSON DRILLING COMPANY, INC.
BY [Signature]
R. L. WELCH

Subscribed and sworn to before me this 17th day of November, 1955.

[Signature]
Edith Erker, Notary Public.



My commission expires:
June 12, 1959

PLUGGING
FILE SEC 22 T 16 R 24W
BOOK PAGE 16 LINE 39

RECEIVED
STATE CORPORATION COMMISSION
NOV 25 1955
11-23-1955
CONSERVATION DIVISION
Wichita, Kansas