

15-135-00218-00-00

STATE OF KANSAS
STATE CORPORATION COMMISSION

Form CP-4


Give All Information Completely
Make Required Affidavit
Mail or Deliver Report to:
Conservation Division
State Corporation Commission
211 No. Broadway
Wichita, Kansas

WELL PLUGGING RECORD

Ness County. Sec. 19 Twp. 16 Rge. (E) 24 (W)

Location as "NE/CNW/SW" or footage from lines C NW NE
Lease Owner Pickrell Drilling Company
Lease Name Everhart Well No. 1
Office Address 705 4th National Bank Bldg, Wichita 2, Kansas
Character of Well (completed as Oil, Gas or Dry Hole) Dry Hole
Date well completed November 30, 1962
Application for plugging filed November 30, 1962
Application for plugging approved November 30, 1962
Plugging commenced November 30, 1962
Plugging completed November 30, 1962
Reason for abandonment of well or producing formation Dry Hole

NORTH

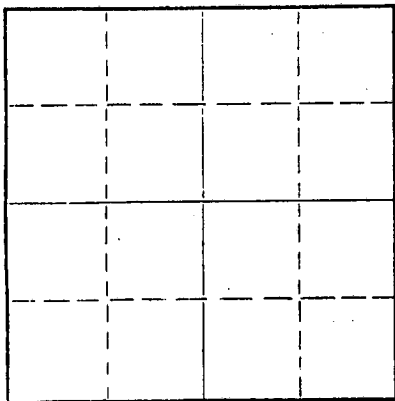

Locate well correctly on above
Section Plat

If a producing well is abandoned, date of last production 19
Was permission obtained from the Conservation Division or its agents before plugging was commenced? Yes

Name of Conservation Agent who supervised plugging of this well Gilbert P. Leiker
Producing formation Depth to top Bottom Total Depth of Well 4580 Feet
Show depth and thickness of all water, oil and gas formations.

OIL, GAS OR WATER RECORDS

CASING RECORD

FORMATION	CONTENT	FROM	TO	SIZE	PUT IN	PULLED OUT
				8 5/8	248'	None

Describe in detail the manner in which the well was plugged, indicating where the mud fluid was placed and the method or methods used in introducing it into the hole. If cement or other plugs were used, state the character of same and depth placed, from feet to feet for each plug set.

Heavy mud to 240'. Set plug. Cemented with
25 sacks cement. Heavy mud to 40'. Set plug.
Cemented with 15 sacks cement to bottom of
cellar. Plugged rat hole with 2 sacks cement.

RECEIVED
STATE CORPORATION COMMISSION

DEC 10 1962
12-10-1962
CONSERVATION DIVISION
Wichita, Kansas

(If additional description is necessary, use BACK of this sheet)

Name of Plugging Contractor Pickrell Drilling Company
Address 705 4th National Bank Bldg, Wichita, 2, Kansas

STATE OF KANSAS, COUNTY OF SEDGWICK, ss.
C. W. SEBITS

(employee of owner or operator) of the above-described well, being first duly sworn on oath, says: That I have knowledge of the facts, statements, and matters herein contained and the log of the above-described well as filed and that the same are true and correct. So help me God.

(Signature) C. W. Sebits
705 4th Nat'l Bk Bldg, Wichita 2, Kansas
(Address)

SUBSCRIBED AND SWORN TO before me this 5th day of December 1962

Maxine Blackman
Maxine Blackman
Notary Public.

My commission expires June 21, 1966

ROTARY DRILLING LOG

15-135-00218-00-00

COMPANY: PICKRELL DRILLING COMPANY
705 4th National Bank Building
Wichita, Kansas
LOCATION: ~ EVERHART NO. 1
C NW NE 19-16-24W,
Ness County, Kansas
CONTRACTOR: **PICKRELL DRILLING COMPANY**
Wichita, Kansas

Rotary Drilling Commenced 11-16-62

Rotary Drilling Completed 11-29-62

CASING RECORD: (5 jts) 8 5/8" Surface Casing set at 242' cemented with 165 sacks cement. Circulated. Completed 12:30 A.M. 11-17-62. No oil string run, D & A.

LOG

(Figures indicate bottom of formation — measurements from top of rotary bushing.)

70	Sand	<u>C. F. S.</u>
500	Shale	4440
750	Shale - Shells	4503
800	Shale & Sand	4508
1045	Shale & Shells	4511
1145	Chalky Lime	4516
1275	Red bed, shale streaks, snad	4521
1285	Blaine	4526
1395	Red Bed & Shale	4531
1610	Sand	4580
1625	Shale	
1890	Shale & Shells	<u>Slope Tests</u>
1925	Anhydrite	2500
2210	Shale & Shells	3000
2380	Shale, Lime & Shells	3500
2425	Shale & Shells	4000
2750	Lime & Shale	
3015	Lime	<u>S. L. M.</u>
3090	Lime & Shale	3621
3190	Lime	3879
3275	Lime & Shale	4085
3525	Shale & Lime	
3600	Sandy Shale - Lime	
3970	Lime & Shale	
4245	Lime	
4440	Lime & Shale	
4491	Lime & Shale	
4511	Conglomerate	
4580	Mississippian - TD	

DEC 10 1962
12-10-1962
CONSERVATION DIVISION
WICHITA, KANSAS

The undersigned, C. W. SEBITS, Attorney-in-Fact for PICKRELL DRILLING COMPANY, hereby certifies in behalf of said Company, that the above is a true and correct log of the formation encountered in drilling the above well as reflected by the Daily Drilling Reports.

PICKRELL DRILLING COMPANY

By C. W. Sebits Attorney-in-Fact

STATE OF KANSAS
COUNTY OF SEDGWICK

ss.:

On this 4th day of December, 19 62, before me the undersigned, a Notary Public, in and for the County and State aforesaid, personally appeared C. W. SEBITS, to me known to be the identical person who subscribed the name of PICKRELL DRILLING COMPANY to the foregoing instrument as its Attorney-in-Fact and acknowledged to me that he executed the same as his free and voluntary act and deed, and as the free and voluntary act and deed of such company, for the uses and purposes therein set forth.

Given under my hand and seal of office the day and year last above written.

My commission expires: June 21, 1966

Maxine Blackman
Maxine Blackman Notary Public