


15-135-21020-00-00

Give All Information Completely
Make Required Affidavit
Well or Deliver Report to:
Conservation Division
State Corporation Commission
P. O. Box 17027
Wichita, Kansas 67217
NORTH

WELL PLUGGING RECORD

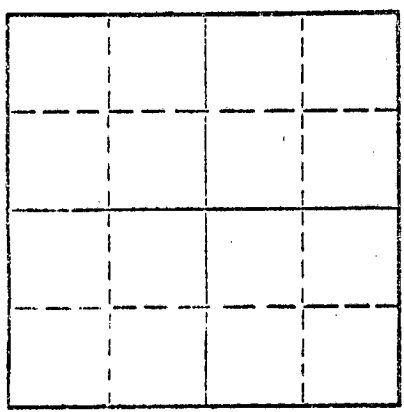

Locate well correctly on above
Section Plat

Ness County, Sec. 30 Twp. 16S Rge. (E) 24 (W)
Location as "NE/CNWxSWx" or footage from lines C/NE SW
Lease Owner Twin Western Resources, Inc.
Lease Name Marhofer Well No. 1
Office Address Suite 920, Union Center, Wichita, Kansas 67202
Character of Well (completed as Oil, Gas or Dry Hole) Dry Hole
Date well completed March 5 19 76
Application for plugging filed March 5 19 76
Application for plugging approved March 5 19 76
Plugging commenced March 5 19 76
Plugging completed March 5 19 76
Reason for abandonment of well or producing formation Dry Hole

If a producing well is abandoned, date of last production 19
Was permission obtained from the Conservation Division or its agents before plugging was commenced? Yes

Name of Conservation Agent who supervised plugging of this well Leo Massey, Hays, Kansas
Producing formation Depth to top Bottom Total Depth of Well 4554 Feet
Show depth and thickness of all water, oil and gas formations.

OIL, GAS OR WATER RECORDS

CASING RECORD

FORMATION	CONTENT	FROM	TO	SIZE	PUT IN	PULLED OUT
	8-5/8"	0	285'			

Describe in detail the manner in which the well was plugged, indicating where the mud fluid was placed and the method or methods used in introducing it into the hole. If cement or other plugs were used, state the character of same and depth placed, from feet to feet for each plug set.
Hole plugged as follows: Plugged at 720' with 70 sacks of 50-50 pozmix and 6% gel; plugged at 250' with 20 sacks of 50-50 pozmix and 6% gel; plugged at 40' with 10 sacks of 50-50 pozmix and 6% gel. Plug down at 3:30 A. M. March 5, 1976.

RECEIVED
STATE CORPORATION COMMISSION

MAR 24 1976
03-24-1976
CONSERVATION DIVISION
Wichita, Kansas

(If additional description is necessary, use BACK of this sheet)

Name of Plugging Contractor Strata Drilling Company
Address P. O. Box 355, Great Bend, Kansas 67530

STATE OF KANSAS, COUNTY OF BARTON, ss.
Kenneth J. Link


(owner or operator) of the above-described well, being first duly sworn on oath, says: That I have knowledge of the facts, statements, and matters herein contained and the log of the above-described well as filed and that the same are true and correct. So help me God.

(Signature) Kenneth J. Link
Kenneth J. Link, President
P. O. Box 355, Great Bend, Kansas 67530
(Address)

Subscribed and Sworn to before me this 5th day of March, 1976

My commission expires December 14, 1977

Elaine H. Taylor
Notary Public.

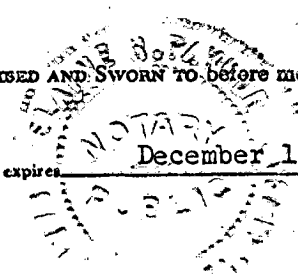

15-135-21026-00-00

DRILLERS LOG

#1 Marhofer

CASING RECORD:
280.30' of used 8-5/8"
surface casing.

COMPANY: Twin Western Resources, Inc.
CONTRACTOR: Strata Drilling Company

DESCRIPTION: C/NE SW
Section 30-16S-24W
Ness County, Kansas

TOTAL DEPTH:
4554'

COMMENCED: February 27, 1976
COMPLETED: March 5, 1976

ELEVATION: 2555' KB

D. & A.

<u>FORMATION</u>	<u>FROM</u>	<u>TO</u>	<u>REMARKS</u>
Surface Soil	0	300	Ran 280.30' of used 8-5/8" surface casing; set and cemented at 285' with 175 sacks of common cement, 2% gel and 3% C. C. Plug down at 3:30 P. M. February 27, 1976.
Shale & Sand	300	1365	
Shale & Sand	1365	1930	
Shale w/Lime Streaks	1930	2520	
Lime & Shale	2520	4554	

ROTARY TOTAL DEPTH: 4554'

Ran one Drill Stem Test.

D. & A.

Hole plugged as follows: Plugged at 720' with 70 sacks of 50-50 pozmix and 6% gel; plugged at 250' with 20 sacks of 50-50 pozmix and 6% gel; plugged at 40' with 10 sacks of 50-50 pozmix and 6% gel. Plug down at 3:30 A. M. March 5, 1976.

RECEIVED
STATE CORPORATION COMMISSION

MAR 24 1976
03-24-1976
CONSERVATION DIVISION
Wichita, Kansas

STATE OF KANSAS)
) ss.
COUNTY OF BARTON)

I certify that this is a true and correct copy of the above log to the best of my knowledge.

STRATA DRILLING COMPANY

Kenneth J. Link
Kenneth J. Link, President

Subscribed and sworn to before me this 5th day of March, 1976.

My Commission Expires:

December 14, 1977

Elaine H. Taylor
Elaine H. Taylor, Notary Public

