

STATE OF KANSAS  
STATE CORPORATION COMMISSION  
200 Colorado Derby Building  
Wichita, Kansas 67202

WELL PLUGGING RECORD  
K.A.R.-82-3-117

API NUMBER 15-135-22676-00-00

LEASE NAME Cline

WELL NUMBER B-1

TYPE OR PRINT  
NOTICE: Fill out completely  
and return to Cons. Div.  
office within 30 days.

2970 Ft. from S Section Line

4420 Ft. from E Section Line

SEC. 15 TWP. 16 RGE. 21 (E or W)

LEASE OPERATOR Pickrell Drilling Co., Inc.

ADDRESS 110 N. Market, Suite 205 Wichita KS 67202

COUNTY Ness

PHONE# (316) 262-8427 OPERATORS LICENSE NO. 5123

Date Well Completed 10-23-84

Character of Well Oil

Plugging Commenced 1-23-92

(Oil, Gas, D&A, SWD, Input, Water Supply Well)

Plugging Completed 1-23-92

The plugging proposal was approved on 1-23-92 (date)

by Dan Goodrow (KCC District Agent's Name)

Is ACO-1 filed? Yes if not, is well log attached? \_\_\_\_\_

Producing Formation Ft. Scott-Chero. Depth to Top 4171 Bottom 4232 T.D. 4310

Show depth and thickness of all water, oil and gas formations.

OIL, GAS OR WATER RECORDS

CASING RECORD

Formation	Content	From	To	Size	Put In	Pulled out
		0	299	8 5/8	299	None
		0	4308	4 1/2	4308	None

Describe in detail the manner in which the well was plugged, indicating where the mud fluid was placed and the method or methods used in introducing it into the hole. If cement or other plugs were used, state the character of same and depth placed, from feet to feet, each set. Allied Cementing Co. pressure checked 8 5/8 x 4 1/2 annulus to 500# σ.k. Pumped down 4 1/2" 215 SX ATL Cement w/500#. Left shut-in with 700#.

(If additional description is necessary, use BACK of this form.)

Name of Plugging Contractor Allied Cementing Co. License No. N/A

Address P.O. Box 31, Russell KS 67665


NAME OF PARTY RESPONSIBLE FOR PLUGGING FEES: Pickrell Drilling Co., Inc.

STATE OF Kansas COUNTY OF Sedgwick, ss.

Jack Gurley (Employee of Operator) or (Operator) of above-described well, being first duly sworn on oath, says: That I have knowledge of the facts, statements, and matters herein contained and the log of the above-described well as filed that the same are true and correct, so help me God.

(Signature) Jack Gurley

(Address) 110 N. Market, Ste. 205 Wichita KS

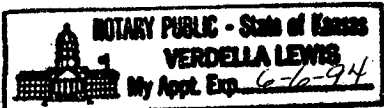

SUBSCRIBED AND SWORN TO before me this 19th day of March, 19 92

Verdelia Lewis  
Notary Public

My Commission Expires: 6-6-94

BAKER SERVICE TOOLS - TALLY PAD


15-135-22676-00-00  New Completion  Workover

Oil Company \_\_\_\_\_ Well No. B-1 Field \_\_\_\_\_ Lease Clive  
Company Man \_\_\_\_\_ Date Drilled 9/84 County Ness State Ks.

RECEIVED  
STATE CORPORATION COMMISSION

NOV 26 1991

STATE CORPORATION COMMISSION  
TOBOLSON

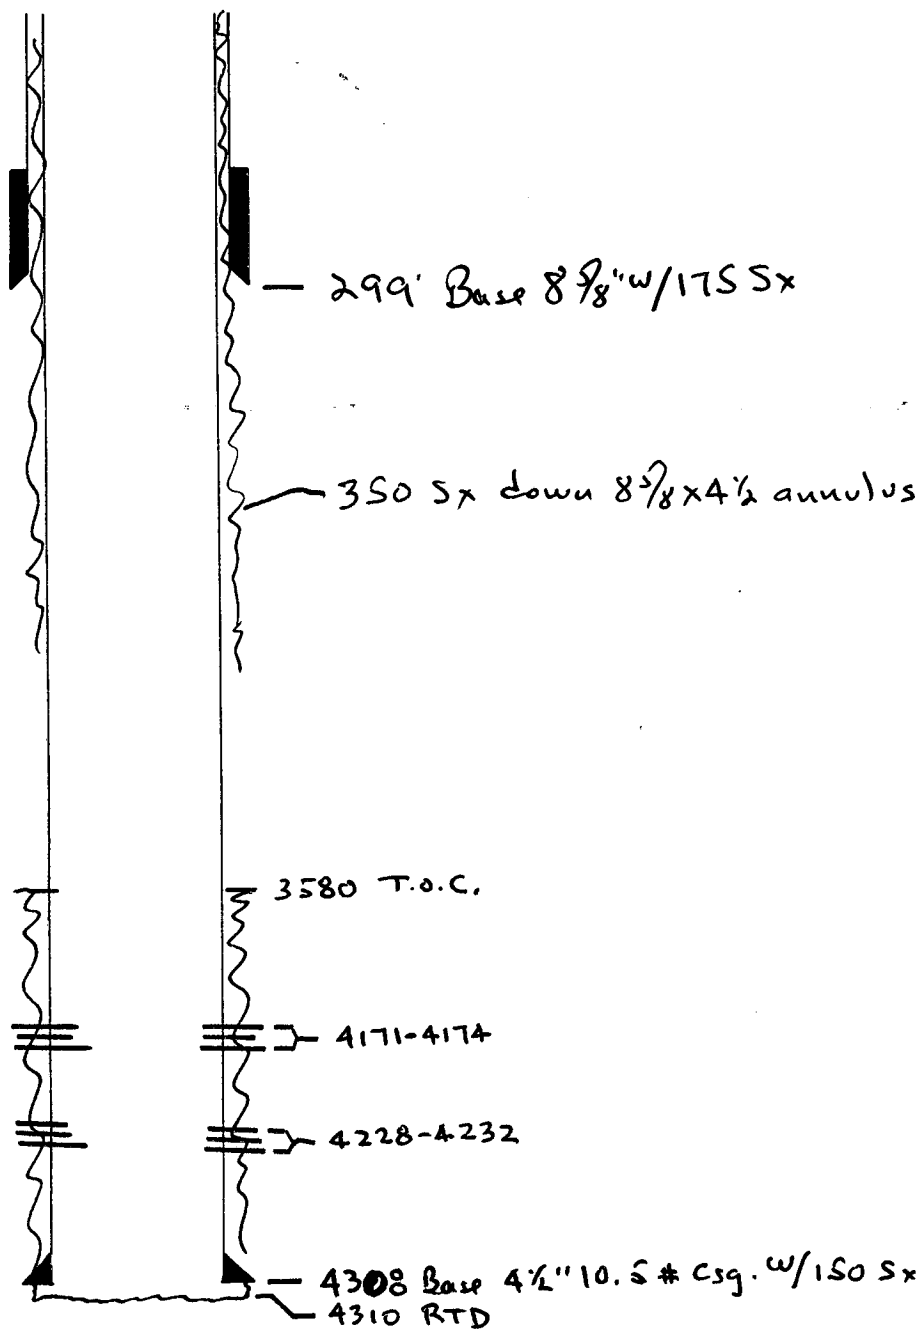

REMARKS: \_\_\_\_\_  
\_\_\_\_\_  
\_\_\_\_\_  
\_\_\_\_\_  
\_\_\_\_\_  
\_\_\_\_\_  
\_\_\_\_\_  
\_\_\_\_\_  
\_\_\_\_\_