

15-135-21145-00-00

STATE OF KANSAS
STATE CORPORATION COMMISSION


Form CP-4

WELL PLUGGING RECORD

Give All Information Completely
Make Required Affidavit
Mail or Deliver Report to:
Conservation Division
State Corporation Commission
P. O. Box 17027
Wichita, Kansas 67217
NORTH

Ness County, Sec. 27 Twp. 16S Rge. 21W (E) (W)

Location as "NE/CNW/SW" or footage from lines SE SW NW
Lease Owner Chief Drilling Co., Inc.
Lease Name Shineman Well No. #2
Office Address 905 Century Plaza, Wichita, Kansas 67202
Character of Well (completed as Oil, Gas or Dry Hole) Dry hole
Date well completed 2/26/76 19
Application for plugging filed 2/26/76 19
Application for plugging approved 2/26/76 19
Plugging commenced 2/26/76 19
Plugging completed 2/26/76 19
Reason for abandonment of well or producing formation Dry hole

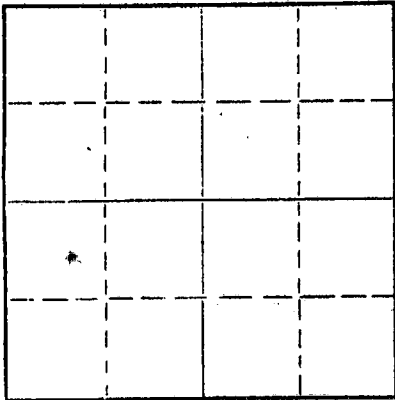

Locate well correctly on above
Section Plat

If a producing well is abandoned, date of last production 19
Was permission obtained from the Conservation Division or its agents before plugging was commenced? Yes

Name of Conservation Agent who supervised plugging of this well Leo Massey, Hays, Kansas
Producing formation Depth to top Bottom Total Depth of Well 4136' Feet
Show depth and thickness of all water, oil and gas formations.

OIL, GAS OR WATER RECORDS

CASING RECORD

FORMATION	CONTENT	FROM	TO	SIZE	PUT IN	PULLED OUT
		0	257'	8 5/8"		

Describe in detail the manner in which the well was plugged, indicating where the mud fluid was placed and the method or methods used in introducing it into the hole. If cement or other plugs were used, state the character of same and depth placed, from feet to feet for each plug set.

Plugged through drill pipe @ 550' w/50 sacks cement.
Plugged through drill pipe @ 240' w/25 sacks cement.
Plugged through drill pipe @ 40' w/10 sacks cement.

RECEIVED
STATE CORPORATION COMMISSION

MAR 01 1976
03-01-1976
CONSERVATION DIVISION
Wichita, Kansas

(If additional description is necessary, use BACK of this sheet)

Name of Plugging Contractor Chief Drilling Co., Inc.
Address 905 Century Plaza, Wichita, Kansas 67202

STATE OF KANSAS, COUNTY OF SEDGWICK, ss.
Jim Robinson (employee of owner) or (owner/operator) of the above-described well, being first duly sworn on oath, says: That I have knowledge of the facts, statements, and matters herein contained and the log of the above-described well as filed and that the same are true and correct. So help me God.

(Signature) Jim Robinson
905 Century Plaza, Wichita, Kansas 67202
(Address)

SUBSCRIBED AND SWORN TO before me this 27th day of February, 1976

My commission expires

MARILYN SINARD
STATE NOTARY PUBLIC
SEDGWICK COUNTY, KANSAS
MY COMM. EXP. APR. 30, 1979

Marilyn Sinard

Notary Public.

WELL LOG

15-135-21145-00-00

CHIEF DRILLING CO., INC.
905 Century Plaza
Wichita, Kansas 67202

#2 Shineman
SE SW NW Sec. 27-16S-21W
Ness County, Kansas

CONTRACTOR: Chief Drilling Co., Inc.
CASING RECORD: 8 5/8" set @ 257', cemented
w/175 sacks Common Quick Set

COMMENCED: 2/17/76
COMPLETED: 2/26/76

FORMATION	FROM	TO	ELEVATIONS
Sand-Shale	0	270	2252 Gr.
Shale-Sand	270	1170	2254 D.F.
Shale	1170	2220	2257 K.B.
Shale-Lime	2220	2425	
Shale	2425	3275	
Shale-Lime	3275	3480	
Lime	3480	4136	
Total Depth	4136		

FORMATION TOPS	
Anhydrite	1541 + 716
Base Anhydrite	1571 + 686
Heebner	3632 - 1375
Lansing	3675 - 1418
Base Kansas City	3957 - 1700
Pawnee	4025 - 1768
Ft. Scott	4118 - 1861
Cherokee Shale	4124 - 1867
Cherokee Sand	4129 - 1872
RTD	4136 - 1879

RECEIVED
STATE CORPORATION COMMISSION

MAR 01 1976
03-01-1976
CONSERVATION DIVISION
Wichita, Kansas

STATE OF KANSAS, COUNTY OF SEDGWICK) ss:

I hereby certify that the above is a true and correct copy of the Driller's Log of the well drilled in the SE SW NW of Section 27-16-21W, Ness County, Kansas, to the best of my knowledge and belief.

CHIEF DRILLING CO., INC.

Jim Robinson
Jim Robinson, Vice-President

Subscribed and sworn to before me this 27th day of February, 1976

MARILYN SINARD
STATE NOTARY PUBLIC
SEDGWICK COUNTY, KANSAS
MY COMM. EXP. APR. 30, 1983

Marilyn Sinard
Marilyn Sinard - Notary Public