


STATE OF KANSAS
STATE CORPORATION COMMISSION

Give All Information Completely
Make Required Affidavit
Mail or Deliver Report to:
Conservation Division
State Corporation Commission
800 Bittling Building
Wichita, Kansas

15-135-00200-00-00
WELL PLUGGING RECORD

NORTH

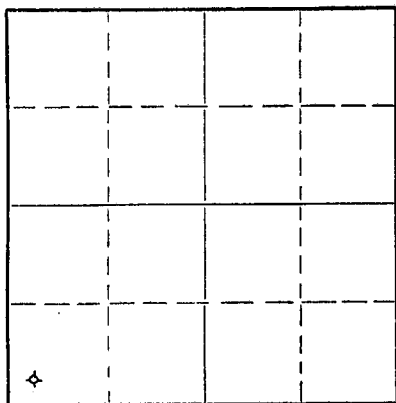

Locate well correctly on above
Section Plat

Ness County. Sec. 23 Twp. 16S Rge. 21 (E) W (W)

Location as "NE/CNW/SW" or footage from lines SW/4 SW/4 SW/4
Lease Owner The Palmer Oil Corporation
Lease Name Ryan Well No. 1
Office Address 415 Union National Bank Bldg, Wichita 2, Kansas
Character of Well (completed as Oil, Gas or Dry Hole) Dry Hole
Date well completed February 11, 19 53
Application for plugging filed (Verbal) February 11, 19 53
Application for plugging approved (Verbal) February 11, 19 53
Plugging commenced February 11, 19 53
Plugging completed February 11, 19 53
Reason for abandonment of well or producing formation Dry Hole

If a producing well is abandoned, date of last production _____ 19____
Was permission obtained from the Conservation Division or its agents before plugging was commenced? Yes

Name of Conservation Agent who supervised plugging of this well _____
Producing formation Arbuckle test Depth to top _____ Bottom _____ Total Depth of Well 4427 Feet
Show depth and thickness of all water, oil and gas formations.

OIL, GAS OR WATER RECORDS

CASING RECORD

FORMATION	CONTENT	FROM	TO	SIZE	PUT IN	PULLED OUT
		0'	284'	8-5/8"	284'	none

Describe in detail the manner in which the well was plugged, indicating where the mud fluid was placed and the method or methods used in introducing it into the hole. If cement or other plugs were used, state the character of same and depth placed, from _____ feet to _____ feet for each plug set.

Pushed bottom plug to 275'. Half sack hulls on plug and 15 sacks cement. Top plug to 35'. Half sack hulls and 10' sacks cement. By orders of state plugger C. D. Stough.


RECEIVED
STATE CORPORATION COMMISSION
FEB 25 1953
CONSERVATION DIVISION

(If additional description is necessary, use BACK of this sheet)
Name of Plugging Contractor Birmingham-Bartlett Drilling Co.
Address 300 Kaufman Building, Wichita 2, Kansas

STATE OF Kansas COUNTY OF Sedgwick, ss.
Richard Hindery, partner of Birmingham-Bartlett Drilling Co., contractor, of the above-described well, being first duly sworn on oath, says: That I have knowledge of the facts, statements, and matters herein contained and the log of the above-described well as filed and that the same are true and correct. So help me God. BIRMINGHAM-BARTLETT DRILLING CO.

(Signature) By Richard Hindery
300 Kaufman Building, Wichita 2, Kansas
(Address)

SUBSCRIBED AND SWORN TO before me this 16th day of February, 19 53
My commission expires October 2, 1954
Beverly Larson Notary Public.

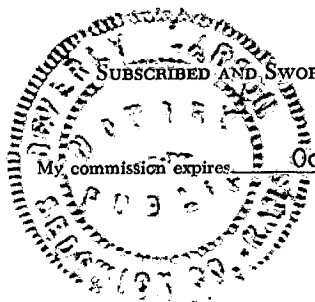

PLUGGING
FILE SEC 23 T 16 R 21
BOOK PAGE 79 LINE 35

15-135-00202-00-00

RYAN NO. 1 WELL

LOCATION: SW/4 SW/4 SW/4 SPUDDED: 1-26-53
 Section 23-16S-21W
 Ness County, Kansas COMPLETED: 2-11-53

OWNER: The Palmer Oil Corporation
 415 Union National Bank Building
 Wichita 2, Kansas

CONTRACTOR: Birmingham-Bartlett Drilling Co.
 300 Kaufman Building
 Wichita 2, Kansas

SURFACE CASING: 8-5/8" casing cemented at 284' with
 170 sacks cement and 2cc.

OIL STRING: None set. Dry & Abandoned

LOG

(Figures indicate bottom of formation)

0 - 285	shale
1040	shale and shells
1220	sand
1440	red bed and shells
1563	red bed
1590	anhydrite
2220	shale and shells
2430	lime and shale
2530	shale
3535	lime and shale
3570	lime
3625	lime and shale
3883	lime
3924	lime and shale
3959	lime
4112	lime and shale
4130	hard lime and chert
4199	lime and shale
4241	chert
4281	lime and shale
4315	lime, shale and chert
4350	chert and shale
4378	lime, shale, chert
4415	arbuckle dolomite
4427	arbuckle
4427	RTD - D & A

The undersigned, Richard Hindery, one of the partners of Birmingham-Bartlett Drilling Co., hereby certifies that the above is a true and correct log of the formations encountered in drilling the Ryan No. 1 Well as shown in the daily drilling reports.

BIRMINGHAM-BARTLETT DRILLING CO.

By Richard Hindery

Subscribed and sworn to before me this 18th day of February 1953.

Beverly Larson
Notary Public

My commission expires October 2, 1954.

02-21-1953

PLUGGING
 FILE SEC 23 T 16 R 2124
 BOOK PAGE 29 LINE 35