


WELL PLUGGING RECORD

Give All Information Completely
Make Required Affidavit
Mail or Deliver Report to:
Conservation Division
State Corporation Commission
212 No. Market
Wichita, Kansas

Ness County, Sec. 18 Twp. 17S Rge. 25 (E) W (W)

Location as "NE/CNW/SW" or footage from lines C SE NW
Lease Owner Pickrell Drilling Company
Lease Name Stutz A Well No. #1
Office Address 705 Fourth National Bank Bldg.; Wichita, Kans.
Character of Well (completed as Oil, Gas or Dry Hole) Oil
Date well completed March 26 19 63
Application for plugging filed September 6 19 69
Application for plugging approved September 10 19 69
Plugging commenced September 25 19 69
Plugging completed September 29 19 69
Reason for abandonment of well or producing formation Depleted

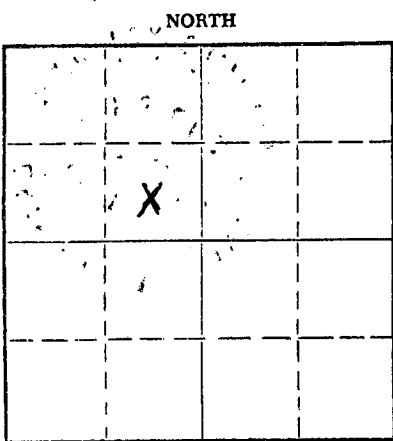

Locate well correctly on above Section Plat

If a producing well is abandoned, date of last production September 4 19 69
Was permission obtained from the Conservation Division or its agents before plugging was commenced? Yes

Name of Conservation Agent who supervised plugging of this well Leo Massey
Producing formation Mississippian Depth to top 4442 Bottom 4510 Total Depth of Well 4510 Feet
Show depth and thickness of all water, oil and gas formations.

OIL, GAS OR WATER RECORDS

CASING RECORD

FORMATION	CONTENT	FROM	TO	SIZE	PUT IN	PULLED OUT
				8 5/8	256	None
				5 1/2	4509	1520
RECEIVED STATE CORPORATION COMMISSION OCT 20 1969 CONSERVATION DIVISION Wichita, Kansas						

Describe in detail the manner in which the well was plugged, indicating where the mud fluid was placed and the method or methods used in introducing it into the hole. If cement or other plugs were used, state the character of same and depth placed, from _____ feet to _____ feet for each plug set.

September 25, 1969 Dumped sand to 4400'. Mixed and dumped 5 sx of cement, to plug off bottom.

September 29, 1969 Mixed and pumped 18 sx of gel, 4 sx of hulls, 70 sx of cement + 6% gel, 7 sx gel, 1 sx hulls and 60 sx of cement + 6% gel.

(If additional description is necessary, use BACK of this sheet)

Name of Plugging Contractor Russ Casing Pulling, Inc.
Address P. O. Box 1082 Great Bend, Kansas 67530

STATE OF Kansas COUNTY OF Sedgwick, ss.
Dale M. Robinson (employee of owner) or (owner or operator) of the above-described

well, being first duly sworn on oath, says: That I have knowledge of the facts, statements, and matters herein contained and the log of the above described well as filed and that the same are true and correct. So help me God.


(Signature) Dale M. Robinson

Date M. Robinson
705 Fourth National Bank Bldg.
Wichita, Kansas (Address)

Wichita, Kansas October 17th day of October, 19 69

Esther Lamone
Esther Lamone Notary Public.

My commission expires Jan. 19, 1973

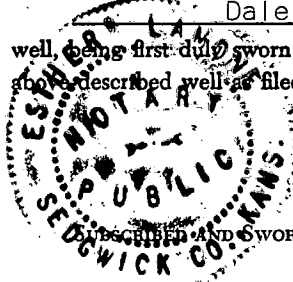

15-135-19088-00-00
ROTARY DRILLING LOG

COMPANY: **PICKRELL DRILLING COMPANY**
705 4th Natl Bank Bldg.
Wichita 2, Kansas

LOCATION: **Stutz "A" No. 1 - C SE NW 18-17-25W,**
Ness County, Kansas

Rotary Drilling Commenced 3--5-63

Rotary Drilling Completed 3-18-63

CONTRACTOR: **PICKRELL DRILLING COMPANY**
Wichita, Kansas

CASING RECORD: (7 jts) 257' 8 5/8" Surface Casing set with 170 sacks cement.
Circulated. (161 jts) 4 1/2" Casing set at 4509' with 100
sacks cement. Completed at 11:10 A.M. 3-18-63.

LOG

(Figures indicate bottom of formation — measurements from top of rotary bushing.)

170	Clay	<u>C. F. S.</u>
500	Blue Shale	4325
755	Shale & Shells	4354
800	Sand	4368
1245	Shale, Shells, Red Bed	4438
1260	Blaine	4442
1345	Shale & Red Bed	4448
1580	Sand	4455
1845	Shale & Shells	4463
1880	Anhydrite	4468
2280	Shale & Shells	4473
2740	Lime & Shale	4510
2930	Lime	
3585	Lime & Shale	
3680	Lime & Sandy Shale	<u>Slope Test</u>
3882	Lime & Shale	1500
4155	Lime	2500
4428	Lime & Shale	3500
4442	Cherty Conglomerate	4000
4455	Miss. Dolomite	
Mississippian - TD - 4510		<u>S. L. M.</u>
		2505
		3387
		4220

RECEIVED
STATE CORPORATION COMMISSION
SEP 8 1969
CONSERVATION DIVISION
Wichita, Kansas

The undersigned, C. W. SEBITS, Attorney-in-Fact for PICKRELL DRILLING COMPANY, hereby certifies in behalf of said Company, that the above is a true and correct log of the formation encountered in drilling the above well as reflected by the Daily Drilling Reports.

PICKRELL DRILLING COMPANY

By C. W. SEBITS Attorney-in-Fact

STATE OF KANSAS }
COUNTY OF SEDGWICK } ss.:

On this 26th day of March, 19 63, before me the undersigned, a Notary Public, in and for

the County and State aforesaid, personally appeared C. W. SEBITS, to me known to be the identical person who subscribed the name of PICKRELL DRILLING COMPANY to the foregoing instrument as its Attorney-in-Fact and acknowledged to me that he executed the same as his free and voluntary act and deed, and as the free and voluntary act and deed of such company, for the uses and purposes therein set forth.

Given under my hand and seal of office the day and year last above written.

My commission expires: June 21, 1966

Maxine Blackman
Maxine Blackman Notary Public