


WELL PLUGGING RECORD

Give All Information Completely
Make Required Affidavit
Mail or Deliver Report to:
Conservation Division
State Corporation Commission
211 No. Broadway
Wichita, Kansas

Ness County, Sec. 18 Twp. 17 Rge. (E) 25 (W)

Location as "NE/CNW/SW" or footage from lines. C SW NE
Lease Owner. Pickrell Drilling Company
Lease Name. Stutz "B" Well No. 1
Office Address. 705 4th National Bank Bldg, Wichita 2, Kansas
Character of Well (completed as Oil, Gas or Dry Hole) Dry Hole
Date well completed. May 31 19 63
Application for plugging filed. May 31 19 63
Application for plugging approved. May 31 19 63
Plugging commenced. May 31 19 63
Plugging completed. May 31 19 63
Reason for abandonment of well or producing formation. Dry Hole

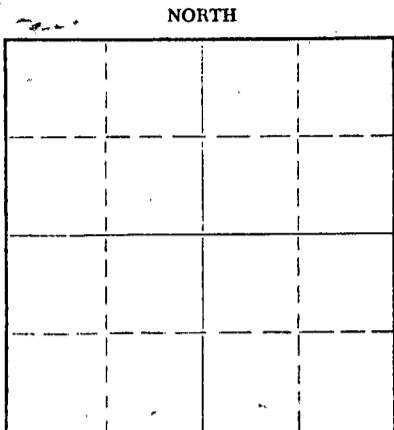

Locate well correctly on above
Section Plat

If a producing well is abandoned, date of last production. 19____
Was permission obtained from the Conservation Division or its agents before plugging was commenced? Yes

Name of Conservation Agent who supervised plugging of this well Gilbert P. Leiker
Producing formation. Depth to top. Bottom. Total Depth of Well 4558 Feet
Show depth and thickness of all water, oil and gas formations.

OIL, GAS OR WATER RECORDS

CASING RECORD

FORMATION	CONTENT	FROM	TO	SIZE	PUT IN	PULLED OUT
				8 5/8	271	None

Describe in detail the manner in which the well was plugged, indicating where the mud fluid was placed and the method or methods used in introducing it into the hole. If cement or other plugs were used, state the character of same and depth placed, from _____ feet to _____ feet for each plug set.

Heavy mud to 240'. Set plug. Cemented with
20' sacks cement. Heavy mud to 30'. Set plug.
Cemented with 5 sacks cement to bottom of
cellar. Plugged rat hole with 2 sacks cement.

RECEIVED
STATE CORPORATION COMMISSION

JUN 18 1963

CONSERVATION DIVISION
Wichita, Kansas


(If additional description is necessary, use BACK of this sheet)

Name of Plugging Contractor. PICKRELL DRILLING COMPANY
Address. 705 4th Natl Bank Bldg, Wichita 2, Kansas

STATE OF KANSAS, COUNTY OF SEDGWICK, ss.
C. W. SEBITS (owner or operator) of the above-described well, being first duly sworn on oath, says: That I have knowledge of the facts, statements, and matters herein contained and the log of the above-described well as filed and that the same are true and correct. So help me God.

(Signature) C. W. Sebits
705 4th Natl Bk Bldg, Wichita 2, Kansas
(Address)

Subscribed and sworn to before me this 4th day of June, 1963

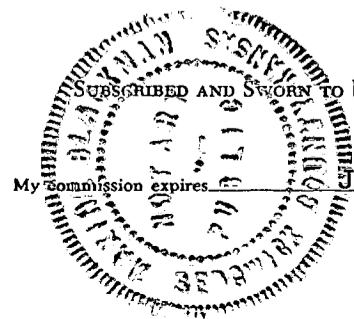

Maxine Blackman
Notary Public.

15-135-19086-00-00

ROTARY DRILLING LOG

COMPANY: PICKRELL DRILLING COMPANY
705 4th Natl Bank Bldg
Wichita, Kansas
LOCATION: Stutz "B" No. 1, C SW NE Sec. 18-17-25W
Ness County, Kansas

Rotary Drilling Commenced 5-18-63
Rotary Drilling Completed 5-30-63

CONTRACTOR: **PICKRELL DRILLING COMPANY**
Wichita, Kansas

CASING RECORD: (7 jts) 8 5/8" Surface Casing set at 271', cemented with 165 sacks cement. Circulated. Completed 6:45 P.M. 5-18-63.
No oil string run. D & A.

LOG

(Figures indicate bottom of formation — measurements from top of rotary bushing.)

60	Top Soil	<u>C. F. S.</u>
272	Shale	4390
750	Shale, Sand & Clay	4430
800	Shale & Clay	4500
920	Sand	4511
1180	Shale & Shells	4517
1290	Shale & Red Beds - Shells	4523
1305	Blaine	4528
1395	Red Bed, Shale & Shells	4533
1625	Sand	4558
1685	Shale & Sand	
1895	Red Bed, Shale & Shells	
1915	Anhydrite	<u>Slope Tests</u>
2170	Red Bed, Shale & Shells	2500
2250	Shale & Shells	3000
2775	Lime & Shale	3500
3075	Lime	4000
3160	Lime & Shale	
3320	Lime	<u>S. L. M.</u>
3910	Lime & Shale	3656
4300	Lime	4095
4398	Lime & Shale	4401
4430	Fort Scott	
4480	Lime & Shale	
4511	Dolomite	
4558	Mississippian - RTD	

RECEIVED
STATE CORPORATION COMMISSION
JUN 18 1963
CONSERVATION DIVISION
Wichita, Kansas

The undersigned, C. W. SEBITS, Attorney-in-Fact for PICKRELL DRILLING COMPANY, hereby certifies in behalf of said Company, that the above is a true and correct log of the formation encountered in drilling the above well as reflected by the Daily Drilling Reports.

PICKRELL DRILLING COMPANY

By C. W. SEBITS Attorney-in-Fact

STATE OF KANSAS }
COUNTY OF SEDGWICK } ss.:

On this 5th day of June, 1963, before me the undersigned, a Notary Public, in and for

the County and State aforesaid, personally appeared C. W. SEBITS, to me known to be the identical person who subscribed the name of PICKRELL DRILLING COMPANY to the foregoing instrument as its Attorney-in-Fact and acknowledged to me that he executed the same as his free and voluntary act and deed, and as the free and voluntary act and deed of such company, for the uses and purposes therein set forth.

Given under my hand and seal of office the day and year last above written.

My commission expires: June 21, 1966

Maxine Blackman
Maxine Blackman Notary Public