


WELL PLUGGING RECORD

Give All Information Completely
Make Required Affidavit
Mail or Deliver Report to:
Conservation Division
State Corporation Commission
P. O. Box 17027
Wichita, Kansas 67217
NORTH

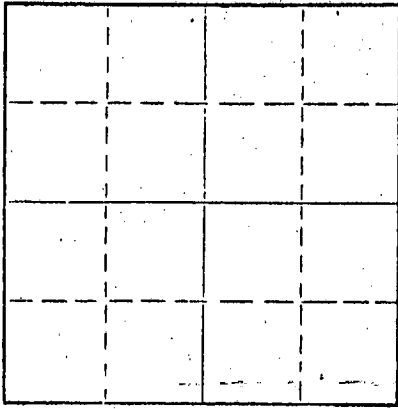

Locate well correctly on above Section Plat

Ness County, Sec. 18 Twp. 17S Rge. (E) 25 (W)
Location as "NE/CNW/SW" or footage from lines C W/2 SW NW
Lease Owner Chief Drilling Co., Inc.
Lease Name Stutz "C" Well No. #1
Office Address 905 Century Plaza, Wichita, Kansas 67202
Character of Well (completed as Oil, Gas or Dry Hole) Dry Hole
Date well completed 3-9-78 19
Application for plugging filed 3-9-78 19
Application for plugging approved 3-9-78 19
Plugging commenced 3-9-78 19
Plugging completed 3-9-78 19
Reason for abandonment of well or producing formation Dry hole

If a producing well is abandoned, date of last production 19
Was permission obtained from the Conservation Division or its agents before plugging was commenced? Yes

Name of Conservation Agent who supervised plugging of this well Leo Massey
Producing formation _____ Depth to top _____ Bottom _____ Total Depth of Well 4447' Feet
Show depth and thickness of all water, oil and gas formations.

OIL, GAS OR WATER RECORDS

CASING RECORD

FORMATION	CONTENT	FROM	TO	SIZE	PUT IN	PULLED OUT
		0	250'	8 5/8"		

Describe in detail the manner in which the well was plugged, indicating where the mud fluid was placed and the method or methods used in introducing it into the hole. If cement or other plugs were used, state the character of same and depth placed, from _____ feet to _____ feet for each plug set.

Plugged through drill pipe @ 720' w/70 sx. cement
Plugged through drill pipe @ 240' w/20 sx. cement
Plugged through drill pipe @ 40' w/10 sx. cement

RECEIVED
STATE CORPORATION COMMISSION
MAR 15 1978
CONSERVATION DIVISION
Wichita, Kansas

Name of Plugging Contractor Chief Drilling Co., Inc.
Address 905 Century Plaza, Wichita, Kansas 67202

STATE OF KANSAS, COUNTY OF SEDGWICK, ss.
Jim Robinson (employee of owner) or (owner or operator) of the above-described well, being first duly sworn on oath, says: That I have knowledge of the facts, statements, and matters herein contained and the log of the above-described well as filed and that the same are true and correct. So help me God.

(Signature) *Jim Robinson*
905 Century Plaza, Wichita, Kansas 67202
(Address)

SUBSCRIBED AND SWORN TO before me this 14th day of March, 19 78

My commission expires _____
MARILYN SINARD
STATE NOTARY PUBLIC
SEDGWICK COUNTY, KANSAS
MY COMM. EXP. APR. 30, 1979

Marilyn Sinard
Marilyn Sinard Notary Public.

15-135-21418-00-00

WELL LOG

CHIEF DRILLING CO., INC.
905 Century Plaza
Wichita, Kansas 67202

#1 STUTZ "C"
C W/2 SW NW Sec. 18-17S-25W
Ness County, Kansas

CONTRACTOR: Warrior Drilling, Inc.
CASING RECORD: 8 5/8" @ 250' w/170 sx.

COMMENCED: February 24, 1978
COMPLETED: March 9, 1978

<u>FORMATION</u>	<u>FROM</u>	<u>TO</u>	<u>ELEVATIONS</u>
Surface Sand	0	248	2478 Gr.
Shale	248	745	2480 D.F.
Shale & Sand	745	1812	2483 K.B.
Anhydrite	1812	1844	
Shale	1844	4325	
Shale & Lime	4325	4447	
Total Depth	4447		

<u>FORMATION TOPS</u>	
Anhydrite	1822 + 661
Base Anhy.	1854 + 629
Heebner	3771 - 1288
Lansing	3811 - 1328
BKC	4128 - 1645
Ft. Scott	4325 - 1842
RTD	4447 - 1964

D & A

STATE OF KANSAS, COUNTY OF SEDGWICK) ss:

I hereby certify that the above is a true and correct copy of the Driller's Log of the well drilled in the C W/2 SW NW Sec. 18-17S-25W, Ness County, Kansas, to the best of my knowledge and belief.

CHIEF DRILLING CO., INC.

Jim Robinson
Jim Robinson, Vice-President

Subscribed and sworn to before me this 14th day of March, 1978.

MARILYN SINARD
STATE NOTARY PUBLIC
SEDGWICK COUNTY, KANSAS
MY COMM. EXP. APR. 30, 1979

Marilyn Sinard
Marilyn Sinard Notary Public