


STATE OF KANSAS  
STATE CORPORATION COMMISSION  
200 Colorado Derby Bldg.  
Wichita, Kansas 67202

WELL PLUGGING RECORD

Give All Information Completely  
Make Required Affidavit

COUNTY Ness SEC. 18 TWP. 17S RGE. 25W E/W  
Location as in quarters or footage from lines:  
660' FSL & 1980' FWL of the SW/4

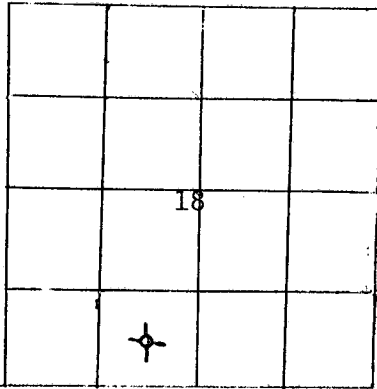

Locate Well  
correctly on above  
Section Platt.

Lease Owner American Energies Corporation  
Lease Name L. Norton Well No. 1  
Office Address 575 Fourth Financial Center, Wichita, Ks. 67202  
Character of Well (Completed as Oil, Gas or Dry Hole): Dry  
Date Well Completed 10/3/83  
Application for plugging filed 10/3/83  
Plugging commenced 10/3/83 @ 1:00 p.m.  
Plugging completed 10/3/83 @ 8:00 p.m.  
Reason for abandonment of well or producing formation \_\_\_\_\_  
Non-commercial quantities  
Was permission obtained from the Conservation Division or it's  
Agent's before plugging was commenced? Yes

Name of Conservation Agent who supervised plugging of this well Paul Luthi  
Producing formation N/A Depth to top \_\_\_\_\_ bottom \_\_\_\_\_ T.D. 4485'  
Show depth and thickness of all water, oil and gas formations.

OIL, GAS OR WATER RECORDS Casing Record


Formation	Content	From	To	Size	Put in	Pulled Out

Describe in detail the manner in which the well was plugged, indicating where the mud fluid was placed and the method or methods used in introducing it into the hold. If cement or other plugs were used, state the character of same and depth placed, from \_\_\_\_\_ feet to \_\_\_\_\_ feet for each plug set. Plugged hole @ 1820' @ 8:20 a.m. w/50 sx., @ 310' w/50 sx. cmt., @ 40' w/wooden plug & 1/2 sx. hulls & put 10 sx. cement on top, 15 sx. in rat hole, 10 sx. in mouse hole, plugged @ 8:00 p.m. 10/3/83, Sun Oilwell Cementing, Oakley, Kansas.

(If additional description is necessary, use BACK of this sheet)  
Name of Plugging Contractor Sun Oilwell Cementing, Oakley, Kansas

STATE OF KANSAS COUNTY OF SEDGWICK, ss.  
I, Van F. Griffin (employee of owner) or owner or operator of the above-described well, being first duly sworn on oath, says: That I have knowledge of the facts, statements, and matters herein contained and the log of the above-described well as filed and that the same are true and correct. So help me God.

(Signature) [Signature]  
575 Fourth Financial Center  
Wichita, Kansas 67202  
(Address)

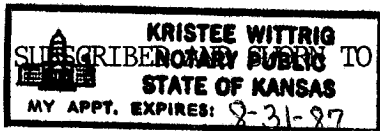

before me this 6th day of October, 1983

Kristee Wittrig  
Notary Public.  
STATE CORPORATION COMMISSION  
RECEIVED  
OCT 11 1983

My Commission expires: August 31, 1987

CONSERVATION DIVISION  
Wichita, Kansas