

STATE OF KANSAS
STATE CORPORATION COMMISSION


WELL PLUGGING RECORD

Give All Information Completely
Make Required Affidavit
Mail or Deliver Report to
Conservation Division
State Corporation Comm.
245 North Water
Wichita, KS 67202

Ness County. Sec. 36 Twp. 17S Rge. 25 E/W
Location as "NE/CNW $\frac{1}{4}$ /SW $\frac{1}{4}$ " or footage from lines 150' SW of NE NE

Lease Owner Pickrell Drilling Company
Lease Name Peddie 'A' Well No. 1

Office Address 110 N. Market, Suite 205, Wichita, KS 67202
Character of Well (Completed as Oil, Gas or Dry Hole) Dry Hole

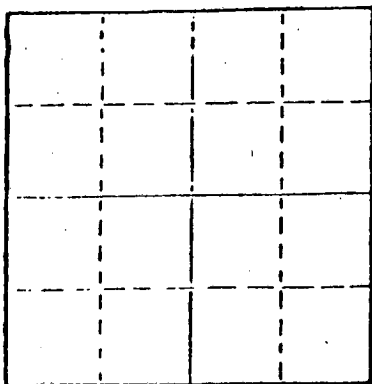

Locate well correctly on above
Section Plat

Date Well completed 4/28/82 19
Application for plugging filed 4/28/82 19
Application for plugging approved 4/28/82 19
Plugging commenced 4/28/82 19
Plugging completed 4/28/82 19
Reason for abandonment of well or producing formation Dry Hole

If a producing well is abandoned, date of last production 19

Was permission obtained from the Conservation Division or its agents before plugging was commenced? Yes

Name of Conservation Agent who supervised plugging of this well _____
Producing formation _____ Depth to top _____ Bottom _____ Total Depth of Well 4370
Show depth and thickness of all water, oil and gas formations.

OIL, GAS OR WATER RECORDS

CASING RECORD

FORMATION	CONTENT	FROM	TO	SIZE	PUT IN	PULLED OUT
				8 5/8"	259' KB	None

Describe in detail the manner in which the well was plugged, indicating where the mud fluid was placed and the method or methods used in introducing it into the hold. If cement or other plugs were used, state the character of same and depth placed, from _____ feet to _____ feet for each plug set.

70 Sx @ 950'
40 Sx @ 270'
10 Sx @ 40' with solid bridge plug
10 Sx in rathole

RECEIVED
STATE CORPORATION COMMISSION

MAY 12 1982

CONSERVATION DIVISION
Wichita, Kansas

(If additional description is necessary, use BACK of this form)
Name of Plugging Contractor Pickrell Drilling Company

STATE OF KANSAS COUNTY OF Sedgwick, ss.
C. W. Sebitts (employee of owner) or (owner or operator)

of the above-described well, being first duly sworn on oath, says: That I have knowledge of the facts, statements, and matters herein contained and the log of the above-described well as filed and that the same are true and correct. So help me God.

(Signature)

110 N. Market, Suite 205

(Address)

SUBSCRIBED AND SWORN TO before me this 11th day of May, 19 82

SUE A. BROWNLEE
NOTARY PUBLIC
STATE OF KANSAS

Sue A. Brownlee
Sue A. Brownlee Notary Public.

My commission expires February 24, 1985