


15-135-21586-0000

STATE OF KANSAS
STATE CORPORATION COMMISSION

WELL PLUGGING RECORD

Give All Information Completely
Make Required Affidavit
Mail or Deliver Report to
Conservation Division
State Corporation Comm.
245 North Water
Wichita, KS 67202

Ness County, Sec. 4 Twp. 17S Rge. 26 ~~XXX~~W
Location as "NE/CNW $\frac{1}{4}$ SW $\frac{1}{4}$ " or footage from lines _____
C SW NE
Lease Owner Sidwell Oil & Gas Co.
Lease Name _____ Dumler Well No. 1-A
Office Address Box 2475, Pampa, Texas 79065
Character of Well (Completed as Oil, Gas or Dry Hole) _____
dry hole

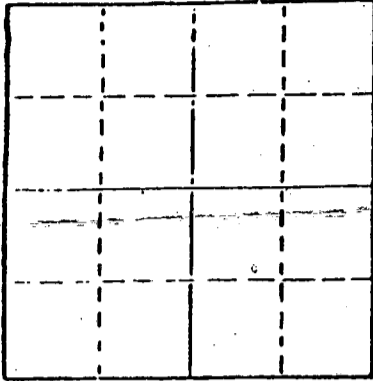

Locate well correctly on above
Section Plot

Date Well completed 2-16 19 79
Application for plugging filed 2-16 19 79
Application for plugging approved 2-16 19 79
Plugging commenced 2-16 19 79
Plugging completed 2-16 19 79
Reason for abandonment of well or producing formation
no commercial quantities of oil or gas encountered
If a producing well is abandoned, date of last production
-- 19

Was permission obtained from the Conservation Division or
its agents before plugging was commenced? yes

Name of Conservation Agent who supervised plugging of this well Leo Massey
Producing formation _____ Depth to top _____ Bottom _____ Total Depth of Well 4610
Show depth and thickness of all water, oil and gas formations.

OIL, GAS OR WATER RECORDS

CASING RECORD

FORMATION	CONTENT	FROM	TO	SIZE	PUT IN	PULLED OUT
surface hole	shale	surf	336'	8-5/8"	329	none

Describe in detail the manner in which the well was plugged, indicating where the mud fluid
was placed and the method or methods used in introducing it into the hold. If cement or other
plugs were used, state the character of same and depth placed, from _____ feet to
_____ feet for each plug set.

Fluid to 720', plug, 70 sx
Fluid to 300', plug, 20 sx
Fluid to 40', plug, 10 sx

(If additional description is necessary, use BACK of this sheet)

Name of Plugging Contractor D N B DRILLING, INC.
515 R. H. Garvey Building
Wichita, Kansas 67202

STATE OF Kansas COUNTY OF Sedgwick, ss.
Ella Priess (employee of owner) or (owner or operator)
of the above-described well, being first duly sworn on oath, says: That I have knowledge of
the facts, statements, and matters herein contained and the log of the above-described well
as filed and that the same are true and correct. So help me God.

(Signature) Ella Priess
Suite 515, R.H. Garvey Bldg., Wichita, Ks.
(Address) 67202

SUBSCRIBED AND SWORN TO before me this 16th day of February, 19 79

My commission expires April 30, 1979

Dorothy L. Schmidt
Dorothy L. Schmidt Notary Public.

DOROTHY L. SCHMIDT
STATE NOTARY PUBLIC
Sedgwick County, Kansas
My Appt. Exp. April 30, 1979

RECEIVED
STATE CORPORATION COMMISSION
FEB 23 1979
CONSERVATION DIVISION
Wichita, Kansas

DRILLER'S LOG

SIDWELL OIL & GAS CO.
 No. 1-A Dumlér
 C SW NE Sec. 4-17S-26W
 Ness Co., Ks.

Commenced: 2-5-79
 Completed: 2-15-79

Surface Casing: 329' of 8-5/8"
 cmtd w/200 sx common, 2% gel,
 3% cc. 2-6-79

FORMATION

DEPTH

Surface Hole	0 - 336
Sand & Lime	336 - 509
Shale w/sand streaks	509 - 1095
Shale	1095 - 1322
Shale & Sand	1322 - 1765
Lime & Shale	1765 - 2072
Shale & Lime	2072 - 2340
Lime & Shale	2340 - 2630
Shale & Lime	2630 - 2820
Lime & Shale	2820 - 3125
Sand & Shale	3125 - 3258
Lime & Shale	3258 - 3540
Shale & Lime	3540 - 3695
Lime & Shale	3695 - 4173
Lime	4173 - 4490
Shale	4490 - 4570
Lime	4570 - 4586
Shale	4586 - 4610 RTD

RECEIVED
 STATE OF KANSAS
 FEB 23 1979
 CONSERVATION DIVISION
 Wichita, Kansas

I do hereby certify that the foregoing statements are true and correct to the best of my knowledge and belief.

D N B DRILLING, INC.

Ella Priess
 Ella Priess

STATE OF KANSAS: ss:

Subscribed and sworn to before me this 21st day of February, 1979.

Dorothy L. Schmidt
 Dorothy L. Schmidt, Notary Public

DOROTHY L. SCHMIDT
 STATE NOTARY PUBLIC
 Sedgewick County, Kansas
 My Appt. Exp. April 30, 1979