

15-135-20012-00-00

Give All Information Completely
Make Required Affidavit
Mail or Deliver Report to:
Conservation Division
State Corporation Commission
211 No. Broadway
Wichita, Kansas

WELL PLUGGING RECORD

Ness County, Sec. 1 Twp. 17S Rge. 21 (W)

Location as "NE/CNW&SW" or footage from lines C SE/4 SE/4

Lease Owner National Cooperative Refinery Association

Lease Name Irvin Well No. 1

Office Address P. O. Box 6, Great Bend, Kansas

Character of Well (completed as Oil, Gas or Dry Hole) Dry Hole

Date well completed July 2 19 66

Application for plugging filed July 11 19 66

Application for plugging approved July 2 19 66


Plugging commenced July 2 19 66

Plugging completed July 2 19 66

Reason for abandonment of well or producing formation Dry Hole - Anhydrite test.

If a producing well is abandoned, date of last production None 19

Was permission obtained from the Conservation Division or its agents before plugging was commenced? Yes

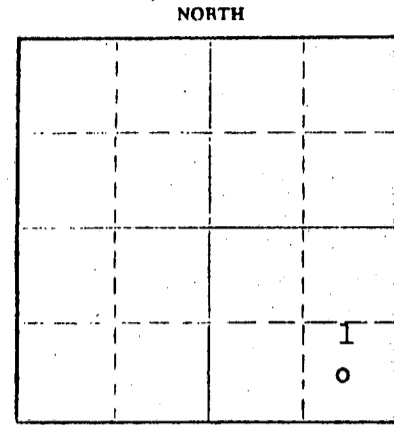

Locate well correctly on above Section Plat

Name of Conservation Agent who supervised plugging of this well Leo Massey

Producing formation None Depth to top --- Bottom --- Total Depth of Well 1490' Feet

Show depth and thickness of all water, oil and gas formations.

OIL, GAS OR WATER RECORDS

CASING RECORD

FORMATION	CONTENT	FROM	TO	SIZE	PUT IN	PULLED OUT
Log Attached					None	None

Describe in detail the manner in which the well was plugged, indicating where the mud fluid was placed and the method or methods used in introducing it into the hole. If cement or other plugs were used, state the character of same and depth placed, from --- feet to --- feet for each plug set.

Drill pipe was run, open-ended, to total depth. Hole was cemented with 327 sacks Common cement, plus 12 per cent Gel., plus 3 per cent salt --- cement circulated. 1490 feet cement left in hole.

RECEIVED
STATE CORPORATION COMMISSION

JUL 13 1966

07-13-1966

CONSERVATION DIVISION
Wichita, Kansas

(If additional description is necessary, use BACK of this sheet)

Name of Plugging Contractor Omega Drilling, Inc.

Address 427 Union Center, Wichita, Kansas.

STATE OF KANSAS, COUNTY OF BARTON, ss.
W. F. Griffith (employee of owner) of the above-described

well, being first duly sworn on oath, says: That I have knowledge of the facts, statements, and matters herein contained and the log of the above-described well as filed and that the same are true and correct. So help me God.

(Signature) W. F. Griffith W. F. Griffith

P. O. Box 6, Great Bend, Kansas (Address)

SUBSCRIBED AND SWORN to before me this 12th day of July, 1966

October 23, 1966.

Irene Kelly Marney Notary Public.

