


STATE OF KANSAS  
STATE CORPORATION COMMISSION

Give All Information Completely  
Make Required Affidavit  
Mail or Deliver Report to:  
Conservation Division  
State Corporation Commission  
800 Biting Building  
Wichita, Kansas

15-051-19437-0000  
WELL PLUGGING RECORD

Ellis County, Sec. 32 Twp. 13S Rge. 16W (E) (W)

NORTH

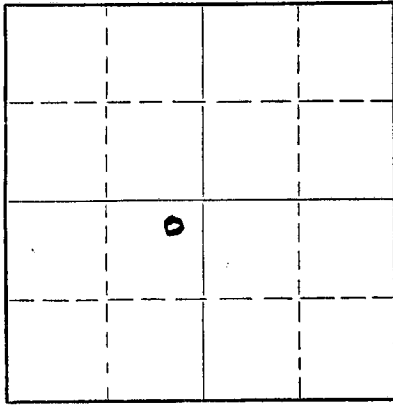

Locate well correctly on above  
Section Plat

Location as "NE/CNW¼SW¼" or footage from lines \_\_\_\_\_  
Lease Owner Shamrock Drilling Company  
Lease Name Kuhn Well No. 1  
Office Address P. O. Box 793, Okla. City, Okla.  
Character of Well (completed as Oil, Gas or Dry Hole) Dry Hole  
Date well completed January 22, 1952 19\_\_\_\_  
Application for plugging filed June 16, 1952 19\_\_\_\_  
Application for plugging approved June 23, 1952 19\_\_\_\_  
Plugging commenced June 21, 1952 19\_\_\_\_  
Plugging completed June 24, 1952 19\_\_\_\_  
Reason for abandonment of well or producing formation \_\_\_\_\_

If a producing well is abandoned, date of last production none 19\_\_\_\_

Was permission obtained from the Conservation Division or its agents before plugging was commenced? yes

Name of Conservation Agent who supervised plugging of this well Eldon Petty, Hays, Kansas  
Producing formation \_\_\_\_\_ Depth to top \_\_\_\_\_ Bottom \_\_\_\_\_ Total Depth of Well 3427 Feet  
Show depth and thickness of all water, oil and gas formations.

OIL, GAS OR WATER RECORDS

CASING RECORD

FORMATION	CONTENT	FROM	TO	SIZE	PUT IN	PULLED OUT
				8-5/8"	139	
				5-1/2"	3422'	2633'

Describe in detail the manner in which the well was plugged, indicating where the mud fluid was placed and the method or methods used in introducing it into the hole. If cement or other plugs were used, state the character of same and depth placed, from \_\_\_\_\_ feet to \_\_\_\_\_ feet for each plug set.

8-5/8" set at 150 feet circulated w/cement.  
5-1/2" set at 3422 feet w/75sax cement behind.  
Filled w/sand to 3420 feet. Set 4 sacks cement w/dump bailer. Pulled 2633 feet of 5-1/2". Filled w/mud to 150 feet. Set rock and 15 sax cement. Filled w/mud to 35 feet. Set rock and 10 sax cement to bottom of cellar.

RECEIVED  
STATE CORPORATION COMMISSION  
SEP 26 1952  
CONSERVATION DIVISION  
Wichita, Kansas

(If additional description is necessary, use BACK of this sheet)

Name of Plugging Contractor Carroll Bros. Casing Pulling Co  
Address Ellinwood, Kansas

STATE OF Oklahoma, COUNTY OF Oklahoma, ss.  
Wm. Trachtenberg ~~XXXXXXXXXXXX~~ or (owner ~~XXXXXXXX~~) of the above-described

well, being first duly sworn on oath, says: That I have knowledge of the facts, statements, and matters herein contained and the log of the above-described well as filed and that the same are true and correct. So help me God.

(Signature) Shamrock Drilling Co

By: Wm Trachtenberg  
(Address) Vice-President

SUBSCRIBED AND SWORN TO before me this 25th. day of September, 1952

My commission expires March 4, 1956

Notary Public.

24-2675-S 2-52-20M

PLUGGING  
FILE SEC 32 T 13 R 162  
BOOK PAGE 25 LINE 15

BRUNSON DRILLING COMPANY, INC. BY AL

Wichita, Kansas

Name: No. 1

NE 1/4 SW, Section 12-13-16W  
Ellis County, Kansas

Commenced No: 1/12/52  
Completed No: 1/22/52  
Total Depth: 3422'

Elevation: 1018 D.P.  
Initial Iron:  
Contractor: Per -Mar Drilling Co., Inc.

Casing: 139' 3 1/2" O.D. 2 1/2" Crd thd  
3422' 5 1/2" O.D. 1 1/2" Crd thd

15-051-19437-00-00

DEPTH	DEPTH
Surface soil & clay	25
Sand & gravel	40
Sand & shale	90
Shale & shells	370
Sand	400
Shale & shells	430
Sand & Rock	450
Sand	670
Shale & red beds	885
Redbeds & shale	1040
Anhydrite	1012
Redbeds & shale	1165
Shale & shells	1490
Salt & shale	1740
Shale & shells	1760
Shale & lime	1993
Lime & shale	2110
Shale & lime	2100
Broken lime	2440
Lime & shale	2510
Shale & lime	2840
Shale & shells	2945
Lime & shale	3267
Lime	3275
Lime & shale	3330
Lime	3422
Total Depth	3422

FORES:

Woolner	3125'	(-1505)
Landing	3171'	(-1251)
Archie	3412'	(-1502)

I hereby certify that the above is a true and correct log of said well as reflected by the daily drilling reports.


BRUNSON DRILLING COMPANY, INC.  
By

*Ralph D. McLaughlin*  
Ralph D. McLaughlin - Sec.-Treas.

Signed and sworn to in my presence this 1st day of February, 1952,  
by Ralph D. McLaughlin, Secretary-Treasurer of the Brunson Drilling  
Company, Inc., a corporation in the State of Kansas.

*Edward C. Coombs*  
Notary Public

This commission expires September 23, 1953.

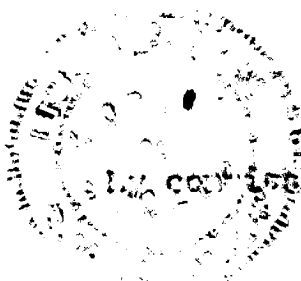

BRUNSON DRILLING COMPANY  
NO. 327.13.16W  
25-1-52