


STATE OF KANSAS
STATE CORPORATION COMMISSION

Form CP-4

15-051-20839-00-00
WELL PLUGGING RECORD

Give All Information Completely
Make Required Affidavit
Mail or Deliver Report to:
Conservation Division
State Corporation Commission
P. O. Box 17027
Wichita, Kansas 67217
NORTH

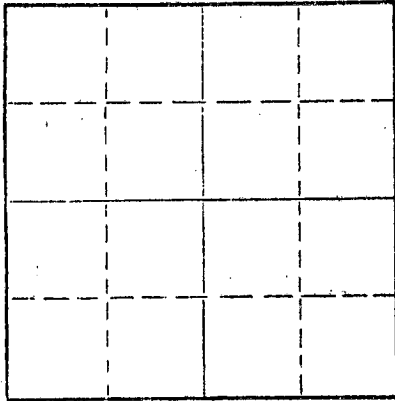

Locate well correctly on above
Section Plat

Ellis County. Sec. 32 Twp. 13S Rge. 16W (E) (W) X
Location as "NE/CNWxSWx" or footage from lines SW NE SW
Lease Owner Jim Allison
Lease Name Braun Well No. #1
Office Address 1415 Wichita Plaza, Wichita, Kansas 67202
Character of Well (completed as Oil, Gas or Dry Hole) D&A
Date well completed August 22 19 72
Application for plugging filed August 22 19 72
Application for plugging approved August 22 19 72
Plugging commenced August 22 19 72
Plugging completed August 22 19 72
Reason for abandonment of well or producing formation D&A

If a producing well is abandoned, date of last production 19
Was permission obtained from the Conservation Division or its agents before plugging was commenced? Yes

Name of Conservation Agent who supervised plugging of this well Leo F. Massey
Producing formation Depth to top Bottom Total Depth of Well 3472 Feet
Show depth and thickness of all water, oil and gas formations.

OIL, GAS OR WATER RECORDS

CASING RECORD

FORMATION	CONTENT	FROM	TO	SIZE	PUT IN	PULLED OUT
				8-5/8"	214'	-0-

Describe in detail the manner in which the well was plugged, indicating where the mud fluid was placed and the method or methods used in introducing it into the hole. If cement or other plugs were used, state the character of same and depth placed, from feet to feet for each plug set.

Filled hole with mud up to 720'.
Cemented with 70 sx 6% Gel-50-50 poz.
Filled hole up to 250', cemented with
25 sx 6% Gel. Filled hole up to 40'
Cemented with 10 sx By Globe, 2 sx in
rathole.

RECEIVED
STATE CORPORATION COMMISSION
AUG 31 1972
CONSERVATION DIVISION
Wichita, Kansas

(If additional description is necessary, use BACK of this sheet)
Name of Plugging Contractor Red Tiger Drilling Co.
Address 1720 Wichita Plaza, Wichita, Kansas 67202


STATE OF Kansas, COUNTY OF Sedgwick, ss.
Virginia Albert (employee of owner) or (owner or operator) of the above-described well, do hereby sworn on oath, says: That I have knowledge of the facts, statements, and matters herein contained and the log of the above-described well as filed and that the same are true and correct. So help me God.

(Signature) Virginia Albert
1720 Wichita Plaza, Wichita, Kansas 67202
(Address)

Sworn to before me this 25th day of August, 1972

Barbara L. Darland
Notary Public.

My commission expires July 25, 1976

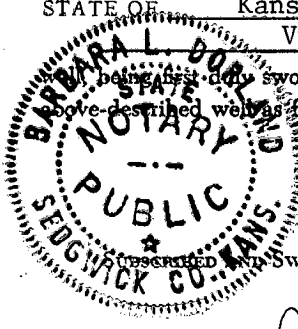

DRILLERS LOG

No. 1 Braun

CASING RECORD:

8-5/8" @ 214'
w/160 ex cement

TOTAL DEPTH: 3472'

COMPANY:

Jim Allison

CONTRACTOR:

Red Tiger Drilling Co.

COMMENCED:

August 12, 1972

COMPLETED:

August 22, 1972

DESCRIPTION:

SW NE SW
32-13S-16W
Ellis County, Kansas

ELEVATION:

15-05L20839-00-00

<u>FORMATION</u>	<u>FROM</u>	<u>TO</u>	<u>REMARKS</u>
Clay, Rock & Sand	0	155	
Shale	155	400	
Sand	400	445	
Shale	445	575	
Sand	575	690	
Shale & Redbed	690	1052	
Anhydrite	1052	1093	
Redbed Shale	1093	1690	
Shale & Lime	1690	2395	
Shale	2395	2505	
Lime & Shale	2505	3030	
Lime	3030	3452	
Arbuckle Lime	3452	3472	

RECEIVED
STATE CORPORATION COMMISSION
AUG 31 1972
CONSERVATION DIVISION
Wichita, Kansas

I certify that this is a true and correct copy of the above log to the best of my knowledge.

RED TIGER DRILLING COMPANY

Virginia K. Albert
Virginia K. Albert

Subscribed and sworn to before me this 25th day of August, 1972.

Barbara L. Dorland
Notary Public

My Commission Expires:
July 25, 1976

