


15:05:0236:00:00
WELL PLUGGING RECORD

NORTH

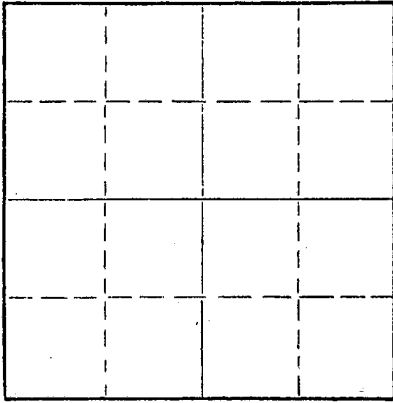

Locate well correctly on above
 Section Flat

Location as "NE/CNW/SW" or footage from lines SE NE NE
 Lease Owner Fred J. Haynes
 Lease Name Dinkel Well No. 1
 Office Address Bldg. & Loan Bldg., Russell, Kansas
 Character of Well (completed as Oil, Gas or Dry Hole) D & A
 Date well completed April 15 19 58
 Application for plugging filed April 15 19 58
 Application for plugging approved April 15 19 58
 Plugging commenced April 15 19 58
 Plugging completed April 15 19 58
 Reason for abandonment of well or producing formation D & A

If a producing well is abandoned, date of last production 19
 Was permission obtained from the Conservation Division or its agents before plugging was commenced? Yes

Name of Conservation Agent who supervised plugging of this well Edon Petty, Box 326, Hays, Kansas
 Producing formation _____ Depth to top _____ Bottom _____ Total Depth of Well 3477 Feet
 Show depth and thickness of all water, oil and gas formations.

OIL, GAS OR WATER RECORDS

CASING RECORD

FORMATION	CONTENT	FROM	TO	SIZE	PUT IN	PULLED OUT
				8 5/8"	210	None

Describe in detail the manner in which the well was plugged, indicating where the mud fluid was placed and the method or methods used in introducing it into the hole. If cement or other plugs were used, state the character of same and depth placed, from _____ feet to _____ feet for each plug set.

Plug set at 180' and cemented with 15 sacks cement, hole filled with mud to 35', plug set at 35' and cemented with 10 sacks cement.

RECEIVED
 STATE CORPORATION COMMISSION

APR 28 1958

CONSERVATION DIVISION
 Wichita, Kansas

(If additional description is necessary, use BACK of this sheet)

Name of Plugging Contractor Haynes Drilling Company
 Address Bldg. & Loan Bldg., Russell, Kansas

STATE OF Kansas, COUNTY OF Russell, ss.
Fred J. Haynes (employee of owner) or (owner or operator) of the above-described well, being first duly sworn on oath, says: That I have knowledge of the facts, statements, and matters herein contained and the log of the above-described well as filed and that the same are true and correct. So help me God.

(Signature) [Signature]
Bldg. & Loan Bldg., Russell, Kansas
 (Address)

SUBSCRIBED AND SWORN TO before me this 25th day of April, 19 58

[Signature]
 Notary Public.

My commission expires January 17, 1961.

PLUGGING
 FILE SEC 32 T. 13 R. 16
 BOOK PAGE 92 LINE 28

DRILLERS LOG

Dinkel # 1
 SE NE NE 32-13-16
 Ellis County, Kansas

15-051-01236-00-00

COMMENCED: April 5, 1958 Casing: 8 5/8 " at 210'w/135sks
 COMPLETED: April 14, 1958 I. P. - D & A
 CONTRACTOR: Haynes Drilling Company
 Russell, Kansas
 OPERATOR: Fred J. Haynes, Bldg. & Loan Bldg., Russell, Kansas

FORMATION:		<u>TOPS</u>	
Surface Clay	20	Anhydrite	1080
		Popeka	2948 (-993)
Sand	30	Heebner	3166
		Tor onto	3185
Shale	210	Lsg.-KC	3214
		Conglomerate	3463
Shale & Shells	440	RTD	3477
Sand, Iron & Pyrite	510		
Iron	520		
Sand	720		
Red Bed & Shale	1040		
Anhydrite	1080-1112		
Shale & Shells	1300		
Shale & Shells	1800		
Lime	2095		
Lime & Shale	2300		
Shale & Lime	2710		
Lime & Shale	3090		
Lime	3495		
Conglomerate	3477		
TD	3477		

I hereby certify that the above is true and correct to the best of my knowledge.

Joseph L. Schulte

PLUGGING
FILE NO. 32-13-16 R(160)
BOOK PAGE 95 LINE 28