


STATE OF KANSAS
STATE CORPORATION COMMISSION

15:051-04006:0000
WELL PLUGGING RECORD

Give All Information Completely
Make Required Affidavit
Mail or Deliver Report to:
Conservation Division
State Corporation Commission
800 Bittling Building
Wichita, Kansas

Ellis County. Sec. 32 Twp. 13S Rge. 16W ~~E~~ (W)

Location as "NE/CNW/SW" or footage from lines. C-NW-NE-SW
Lease Owner Cooperative Refinery Association
Lease Name Kuhn "E" Well No. 1
Office Address Box 765 Gt. Bend, Kansas
Character of Well (completed as Oil, Gas or Dry Hole) Dry hole
Date well completed June 10 19 56
Application for plugging filed Verbal permission was obtained 19
Application for plugging approved 19
Plugging commenced June 10 19 56
Plugging completed June 10 19 56
Reason for abandonment of well or producing formation Dry hole

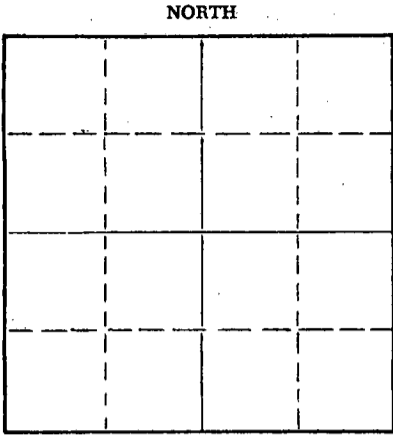

Locate well correctly on above Section Plat

If a producing well is abandoned, date of last production 19
Was permission obtained from the Conservation Division or its agents before plugging was commenced? yes

Name of Conservation Agent who supervised plugging of this well Eldon Petty
Producing formation _____ Depth to top _____ Bottom _____ Total Depth of Well 3490 Feet
Show depth and thickness of all water, oil and gas formations.

OIL, GAS OR WATER RECORDS

CASING RECORD

FORMATION	CONTENT	FROM	TO	SIZE	PUT IN	PULLED OUT
				8 5/8	194'	-0-

Describe in detail the manner in which the well was plugged, indicating where the mud fluid was placed and the method or methods used in introducing it into the hole. If cement or other plugs were used, state the character of same and depth placed, from _____ feet to _____ feet for each plug set.

Filled with heavy mud to 180'. Set first plug at 180', 1/2 sx. hulls. Cemented with 20 sx. cement. Top plug at 40'. Cemented with 10 sx. to surface.

(If additional description is necessary, use BACK of this sheet)

Name of Plugging Contractor Chas. Hulme Drig. Cont.
Address Great Bend, Kansas

STATE OF KANSAS, COUNTY OF BARTON, ss.
Marvin D. Sullivan (employee of owner) or (owner or operator) of the above-described well, being first duly sworn on oath, says: That I have knowledge of the facts, statements, and matters herein contained and the log of the above-described well as filed and that the same are true and correct. So help me God.

(Signature) M. D. Sullivan
Box 765 Gt. Bend, Kansas (Address)

SUBSCRIBED AND SWORN to before me this 12 day of June, 19 56

My commission expires September 2, 1959



Ruth V. Love Notary Public.
RECEIVED
STATE CORPORATION COMMISSION

PLUGGING
FILE SEC 32 T. 13 R. 16W
BOOK PAGE 70 LINE 41

JUN 13 1956
CONSERVATION DIVISION
Wichita, Kansas

DRILLERS LOG

Kuhn "E" #1

Elevation: 1930 D.F. 1933 R.B.
Casing: 8 5/8 @ / 194' w/ 130. sx.
posmix, 3% C.C.

Loc: C-NW-NE-SW
Sec: 32-13S-16W

Ellis County, Kansas

Operator: Cooperative Refinery Ass'n.

Comm: 6-1-56 Comp: 6-10-56

Contractor: Chas. Hulme Drlg. Contractor

Total Depth: 3490

15:05:04006:00:00

<u>From</u>	<u>To</u>	<u>Formation</u>
0	194	Surface clay and iron
194	410	Shale
410	490	Shale and shells
490	520	Iron
520	985	Shale and shells
985	1180	Shale and salt
1180	1890	Shale and lime
1890	2140	Lime
2140	2275	Shale and sand
2275	2425	Shale and lime
2425	2550	Lime
2550	3040	Lime and shale
3040	3100	Lime
3100	3140	Lime, shale, sand
3140	3490	Lime
3490		R.T.D.

(STATE OF KANSAS)

(COUNTY OF BARTON)

I hereby certify that the above is a true and correct copy of the log on the Kuhn "E" #1 well, located C-NW NE SW of Section 32-13S-16W, Ellis County, Kansas.

P. H. Jackson

Subscribed and sworn to before me this 11 day of June 1956.

Ruth U Love



My commission expires: September 2, 1959

PLUGGING
FILE SEC 32 T 13 R 16W
BOOK PAGE 70 LINE 41

Wichita, Kan.