

CARD MUST BE TYPED

State of Kansas NOTICE OF INTENTION TO DRILL

CARD MUST BE SIGNED

(see rules on reverse side)

Starting Date: September 19, 1984
month day year 4 27

API Number 15- 169-20,260-00-00

OPERATOR: License # 5188
Name SILVER CREEK OIL & GAS, INC.
Address 1900 No. Amidon, Suite 221
City/State/Zip Wichita, KS 67203
Contact Person Gregory B. Porterfield
Phone 832-0603

C. E./2, E./2, SW Sec 29. Twp 16 S, Rge 3... East West
(location)

1320 Ft North from Southeast Corner of Section
2970 Ft West from Southeast Corner of Section
(Note: Locate well on Section Plat on reverse side)

CONTRACTOR: License # 5107
Name H-30 Drilling
City/State Wichita, Kansas 67202

Nearest lease or unit boundary line 330 feet.
County Saline


Lease Name Lockstrom Well# 1

Well Drilled For: Well Class: Type Equipment:
 Oil Swd Infield Mud Rotary
 Gas Inj Pool Ext. Air Rotary
 OWWO Expl Wildcat Cable

Domestic well within 330 feet: yes no
Municipal well within one mile: yes no

If OWWO: old well info as follows:

Operator
Well Name
Comp Date Old Total Depth
Projected Total Depth 3600 feet
Projected Formation at TD Simpson
Expected Producing Formations Maquoketa

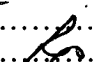Depth to Bottom of fresh water 100 feet
Lowest usable water formation Wellington
Depth to Bottom of usable water 200 feet
Surface pipe by Alternate: 1 2
Surface pipe to be set 335 ± feet
Conductor pipe if any required 100 or needed feet
Ground surface elevation feet MSL
This Authorization Expires 3-19-85
Approved By 9-19-84 

I certify that we will comply with K.S.A. 55-101, et seq., plus eventually plugging hole to K.C.C. specifications.

Date Sept 19 '84 Signature of Operator or Agent 

Title

see
MHC/MOHE 9/19/84

WICHITA, KANSAS
 CONSERVATION DIVISION


Must be filed with the K.C.C. five (5) days prior to commencing well
 This card void if drilling not started within six (6) months of date received by K.C.C.

WICHITA, KANSAS

SEP 19 1984

SEP 19 1984

MAILED
 Regular Section of Land
 1 Mile 5-280 Ft.
 RECEIVED

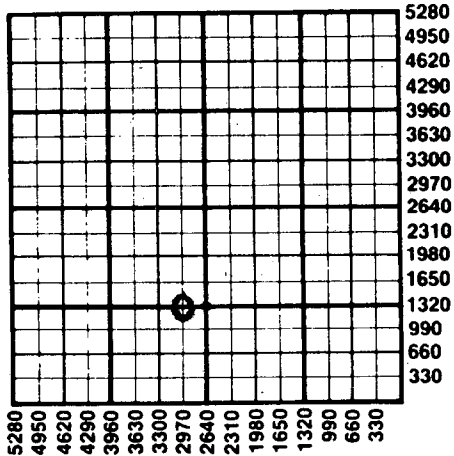

Important procedures to follow :

1. Notify District office before setting surface casing.
2. Set surface casing by circulating cement to the top.
3. File completion forms ACO-1 with K.C.C. within 90 days of well completion, following instructions on ACO-1, side 1, and including copies of wireline logs.
4. Notify District office 48 hours prior to old well workover or re-entry.
5. Prior to plugging, prepare a plugging plan, then obtain agreement from the appropriate district office for an approved plugging plan.
6. Submit plugging report (CP-4) to K.C.C. after plugging is completed.
7. Obtain an approved injection docket number before disposing of salt water.
8. Notify K.C.C. within 10 days when injection commences or terminates.
9. If an alternate 2 completion, cement in the production pipe from below any usable water to surface within 120 days of spud date.

**State Corporation Commission of Kansas
 Conservation Division
 200 Colorado Derby Building
 Wichita, Kansas 67202
 (316) 263-3238**