



State of Kansas

CARD MUST BE TYPED

NOTICE OF INTENTION TO DRILL

CARD MUST BE SIGNED

(see rules on reverse side)

Starting Date: 03/31/85
month day year

API Number 15- 169-20,280-00-00

OPERATOR: License # 5188
Name SILVER CREEK OIL & GAS, INC.
Address 1900 N. Amidon, Ste. 221
City/State/Zip Wichita, KS 67203
Contact Person Gregory B. Porterfield
Phone (316) 832-0603

SW SW SE
(location) Sec 20 Twp 16 S, Rge 3
330 Ft North from Southeast Corner of Section
2305 Ft West from Southeast Corner of Section
(Note: Locate well on Section Plat on reverse side)

CONTRACTOR: License # 5107
Name H-30 Drilling Co.
City/State Wichita, KS

Nearest lease or unit boundary line 330 feet.
County Saline
Lease Name Dyck Well# 1A

Well Drilled For: Well Class: Type Equipment:
 Oil Swd Infield Mud Rotary
 Gas Inj Pool Ext. Air Rotary
 OWWO Expl Wildcat Cable

Domestic well within 330 feet: yes no
Municipal well within one mile: yes no

If OWWO: old well info as follows:

Operator
Well Name
Comp Date Old Total Depth
Projected Total Depth 3600 feet
Projected Formation at TD 3450
Expected Producing Formations Maquoketa

Depth to Bottom of fresh water 100 feet
Lowest usable water formation Wellington
Depth to Bottom of usable water 200 feet
Surface pipe by Alternate: 1 2
Surface pipe to be set 335 + feet
Conductor pipe if any required 100 as needed feet
Ground surface elevation feet MSL.
This Authorization Expires 10-1-85
Approved By 4-4-85 [Signature]

I certify that we will comply with K.S.A. 55-101, et seq., plus eventually plugging hole to K.C.C. specifications.
The original well needed to be skidded due to surface conditions.

Date Signature of Operator or Agent

[Signature]


API # 15-169-20,277

RECEIVED Must be filed with the K.C.C. five (5) days prior to commencing well completion or drilling not started within six (6) months of date received by K.C.C.
 STATE CORPORATION COMMISSION

APR 4 1985

CONSERVATION DIVISION
 Wichita, Kansas

**A Regular Section of Land
 1 Mile = 5,280 Ft.**

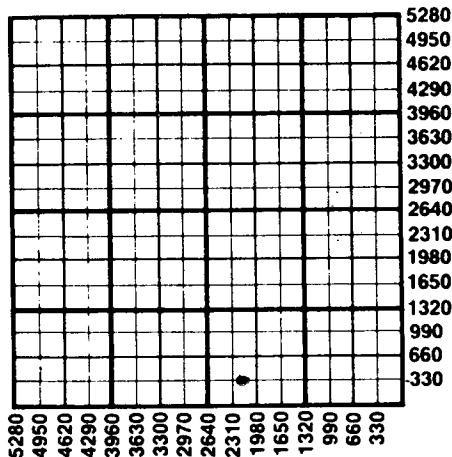

Important procedures to follow :

1. Notify District office before setting surface casing.
2. Set surface casing by circulating cement to the top.
3. File completion forms ACO-1 with K.C.C. within 90 days of well completion, following instructions on ACO-1, side 1, and including copies of wireline logs.
4. Notify District office 48 hours prior to old well workover or re-entry.
5. Prior to plugging, prepare a plugging plan, then obtain agreement from the appropriate district office for an approved plugging plan.
6. Submit plugging report (CP-4) to K.C.C. after plugging is completed.
7. Obtain an approved injection docket number before disposing of salt water.
8. Notify K.C.C. within 10 days when injection commences or terminates.
9. If an alternate 2 completion, cement in the production pipe from below any usable water to surface within 120 days of spud date.

**State Corporation Commission of Kansas
 Conservation Division
 200 Colorado Derby Building
 Wichita, Kansas 67202
 (316) 263-3238**