

CARD MUST BE TYPED

State of Kansas
NOTICE OF INTENTION TO DRILL

CARD MUST BE SIGNED

(see rules on reverse side)

Starting Date: August 20 1984
month day year

API Number 15-

169-20, 256-00-00

OPERATOR: License # 5188

Name SILVER CREEK OIL & GAS, INC.

Address 1900 No. Amidon Suite 221

City/State/Zip Wichita, Kansas 67203

Contact Person Greg Porterfield

Phone 316-832-0603

CONTRACTOR: License # 5107

Name H-30

City/State Wichita, Kansas

Well Drilled For: Well Class: Type Equipment:

- Oil Swd Infield Mud Rotary
- Gas Inj Pool Ext. Air Rotary
- OWWO Expl Wildcat Cable

If OWWO: old well info as follows:

Operator

Well Name

Comp Date Old Total Depth

Projected Total Depth 3600 feet

Projected Formation at TD Simpson

Expected Producing Formations Maquoketa

SE NE NW East
Sec 20 Twp 16 S, Rge 3 West
(location)

4290 Ft North from Southeast Corner of Section
2970 Ft West from Southeast Corner of Section
(Note: Locate well on Section Plat on reverse side)

Nearest lease or unit boundary line 330 feet.
County Saline

Lease Name J.B. Smith Well# 1

Domestic well within 330 feet: yes no

Municipal well within one mile: yes no

Depth to Bottom of fresh water 100 feet

Lowest usable water formation Wellington

Depth to Bottom of usable water 200 feet

Surface pipe by Alternate: 1 2

Surface pipe to be set 300 ft

Conductor pipe if any required 100 ft as needed

Ground surface elevation feet MSL

This Authorization Expires 2-17-85

Approved By 8-17-84 [Signature]

I certify that we will comply with K.S.A. 55-101, et seq., plus eventually plugging hole to K.C.C. specifications.

Date 08-14-84 Signature of Operator or Agent


[Signature] Title Secretary

**Must be filed with the K.C.C. five (5) days prior to commencing well
This card void if drilling not started within six (6) months of date received by K.C.C.**

RECEIVED
STATE CORPORATION COMMISSION

Important procedures to follow: AUG 17 1984

**A Regular Section of Land
1 Mile = 5,280 Ft.**

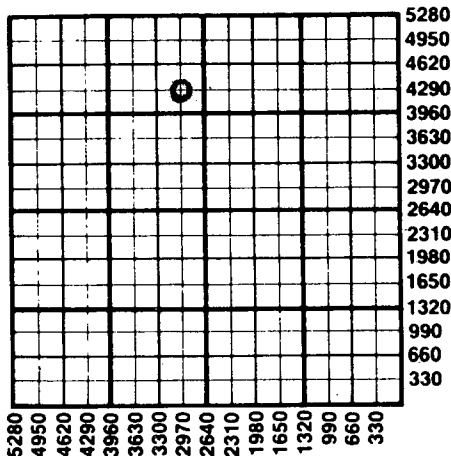

1. Notify District office before setting surface casing. CONSERVATION DIVISION
Wichita, Kansas
2. Set surface casing by circulating cement to the top.
3. File completion forms ACO-1 with K.C.C. within 90 days of well completion, following instructions on ACO-1, side 1, and including copies of wireline logs.
4. Notify District office 48 hours prior to old well workover or re-entry.
5. Prior to plugging, prepare a plugging plan, then obtain agreement from the appropriate district office for an approved plugging plan.
6. Submit plugging report (CP-4) to K.C.C. after plugging is completed.
7. Obtain an approved injection docket number before disposing of salt water.
8. Notify K.C.C. within 10 days when injection commences or terminates.
9. If an alternate 2 completion, cement in the production pipe from below any usable water to surface within 120 days of spud date.

**State Corporation Commission of Kansas
Conservation Division
200 Colorado Derby Building
Wichita, Kansas 67202
(316) 263-3238**