

CARD MUST BE TYPED

State of Kansas
NOTICE OF INTENTION TO DRILL
(see rules on reverse side)

CARD MUST BE SIGNED

Starting Date: 11 31 84
month day year

API Number 15- 101-21,072-00-00

OPERATOR: License # 5420

SE NE NE 25 17 29 East
(location) Sec Twp S, Rge West

Name White & Ellis Drilling, Inc.

Address 401 E. Douglas, Suite 500

City/State/Zip Wichita, Kansas 67202

Contact Person Micheal W. Dixon

Phone (316) 263-1102

... 4290 Ft North from Southeast Corner of Section

... 330 Ft West from Southeast Corner of Section

(Note: Locate well on Section Plat on reverse side)

CONTRACTOR: License # 5420

Name White & Ellis Drilling, Inc.

City/State Wichita, Kansas 67202

Nearest lease or unit boundary line 330 feet.

County Lane

Lease Name Riley Well# 1

Domestic well within 330 feet : yes no

Municipal well within one mile : yes no

Well Drilled For: Well Class: Type Equipment:

- Oil Swd Infield Mud Rotary
- Gas Inj Pool Ext. Air Rotary
- OWWO Expl Wildcat Cable

If OWWO: old well info as follows:

Operator

Well Name

Comp Date Old Total Depth

Projected Total Depth 4600' feet

Projected Formation at TD Mississippian

Expected Producing Formations L/KC - Miss

Depth to Bottom of fresh water 152' feet

Lowest usable water formation Dakota

Depth to Bottom of usable water 1100' feet

Surface pipe by Alternate : 1 2

Surface pipe to be set 350' feet

Conductor pipe if any required None feet

Ground surface elevation feet MSL

This Authorization Expires 4-22-85

Approved By 10-22-84 *PC*

I certify that we will comply with K.S.A. 55-101, et seq., plus eventually plugging hole to K.C.C. specifications.

Date 10/19/84 Signature of Operator or Agent *Micheal W. Dixon*

Title Geologist

Form C-1 4/84


MHC/KOHE 10/22/84

Must be filed with the K.C.C. five (5) days prior to commencing well
 This card void if drilling not started within six (6) months of date received by K.C.C.

OCT 22 1984

10-22-1984

STATE CORPORATION COMMISSION
A Regular Section of Land
 1 Mile = 5,280 Ft.

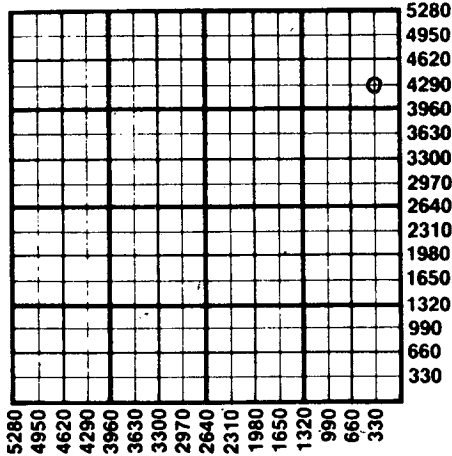

Important procedures to follow :

1. Notify District office before setting surface casing.
2. Set surface casing by circulating cement to the top.
3. File completion forms ACO-1 with K.C.C. within 90 days of well completion, following instructions on ACO-1, side 1, and including copies of wireline logs.
4. Notify District office 48 hours prior to old well workover or re-entry.
5. Prior to plugging, prepare a plugging plan, then obtain agreement from the appropriate district office for an approved plugging plan.
6. Submit plugging report (CP-4) to K.C.C. after plugging is completed.
7. Obtain an approved injection docket number before disposing of salt water.
8. Notify K.C.C. within 10 days when injection commences or terminates.
9. If an alternate 2 completion, cement in the production pipe from below any usable water to surface within 120 days of spud date.

State Corporation Commission of Kansas
Conservation Division
200 Colorado Derby Building
Wichita, Kansas 67202
(316) 263-3238