

CARD MUST BE TYPED

State of Kansas

CARD MUST BE SIGNED

NOTICE OF INTENTION TO DRILL

(see rules on reverse side)

CORRECTED

CORRECTED
*
✓
— East DRY

Expected Spud Date: October 12, 1987
month day year

API Number 15— 101-21,427-00-00

OPERATOR: License # 9421
Name Boger Brothers Drilling Inc.
Address P.O. Box 723
City/State/Zip Great Bend, KS 67530
Contact Person Dale Smith
Phone (316) 792-8151

C-E/2.E/2.SE Sec. 9 Twp. 17 S, Rg. 29 West
1320 Ft. from South Line of Section
330 Ft. from East Line of Section

(Note: Locate well on Section Plat on reverse side)

CONTRACTOR: License # 9421
Name Boger Brothers Drilling Inc.
City/State Great Bend, KS

Nearest lease or unit boundary line 330 feet
County Lane

Lease Name Snider Well # 1

Ground surface elevation 2807 feet MSL

Well Drilled For: Well Class: Type Equipment:
 Oil Storage Infield Mud Rotary
 Gas Inj " Pool Ext. Air Rotary
 OWWO Expl Wildcat Cable

Domestic well within 330 feet: yes no

Municipal well within one mile: yes no

Depth to bottom of fresh water 150

Depth to bottom of usable water 1350

Surface pipe by Alternate: 1 2

* Surface pipe planned to be set 200

Conductor pipe required None

Projected Total Depth 4650 feet

Formation Mississippi

If OWWO: old well info as follows:

Operator
Well Name
Comp Date Old Total Depth

I certify that well will comply with K.S.A. 55-101, et seq., plus eventually plugging hole to KCC specifications.

Date 10-9-87 Signature of Operator or Agent Dale Smith Title Drilling Superintendent

For KCC Use:

Conductor Pipe Required _____ feet; Minimum Surface Pipe Required 200 feet per Alt. Y 2

This Authorization Expires 4-6-88 Approved By RCH 10-13-87

* WAS: 350' S.P.


ORIG. RCV'D
10-6-87

Must be filed with the K.C.C. five (5) days prior to commencing well
This card void if drilling not started within six (6)-months of date received by K.C.C.

Important procedures to follow:

1. Notify District office before setting surface casing.
2. Set surface casing by circulating cement to the top.
3. File completion forms ACO-1 with K.C.C. within 120 days of well spud date, following instructions on ACO-1, side 1, and including copies of wireline logs.
4. Notify District office 48 hours prior to old well workover or re-entry.
5. Prior to filing Intent, prepare a proposed plugging plan in case well is D & A, then obtain approval of plan when calling district office prior to setting surface pipe.
6. Submit plugging report (CP-4) to K.C.C. after plugging is completed.
7. Obtain an approved injection docket number before disposing of salt water.
8. Notify K.C.C. within 10 days when injection commences or terminates.
9. If an alternate 2 completion, cement in the production pipe from below any usable water to surface within 120 days of spud date.

A Regular Section of Land
1 Mile = 5,280 Ft.

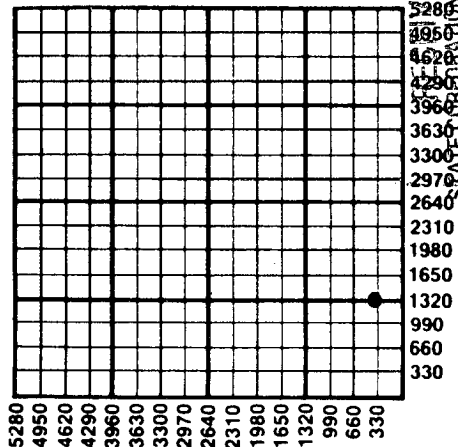

OCT 12 1987

RECEIVED
STATE CORPORATION COMMISSION
Conservation Division
Wichita, Kansas

10-12-1987

State Corporation Commission of Kansas
Conservation Division
200 Colorado Derby Building
Wichita, Kansas 67202-1212
(316) 263-3238