

CARD MUST BE TYPED

State of Kansas NOTICE OF INTENTION TO DRILL

CARD MUST BE SIGNED

(see rules on reverse side)

Starting Date: 9 6 85
month day year

API Number 15- 101-21, 220-00-00

OPERATOR: License # 5886

NE SE NW Sec 17 Twp 18 S, Rge 27
(location) East West

Name Chief Drilling Co., Inc

Address 905 Century Plaza Bldg

City/State/Zip Wichita, Kansas 67202

Contact Person Doug Thimesch

Phone 262-3791

3630 Ft North from Southeast Corner of Section

2970 Ft West from Southeast Corner of Section

(Note: Locate well on Section Plat on reverse side)

CONTRACTOR: License # 5883

Nearest lease or unit boundary line 330 feet

County Lane

Name Warrior Drilling, Rig II

Lease Name Stanley 'A' Well# 1

City/State Wichita, Kansas 67202

Domestic well within 330 feet: yes no

Municipal well within one mile: yes no

Well Drilled For: Well Class: Type Equipment:

- Oil Swd Infield Mud Rotary
- Gas Inj Pool Ext. Air Rotary
- OWWO Expl Wildcat Cable

Depth to Bottom of fresh water 150 feet

Lowest usable water formation Lower Cretaceous

Depth to Bottom of usable water 900 feet

Surface pipe by Alternate: 1 2

Surface pipe to be set 250 feet

Conductor pipe if any required None feet

Ground surface elevation will provide feet MSL

This Authorization Expires 3-5-86

Approved By 9-5-85

If OWWO: old well info as follows:

Operator

Well Name

Comp Date Old Total Depth

Projected Total Depth 4600 feet

Projected Formation at TD Miss

Expected Producing Formations Cherokee

will cement production string immediately

I certify that we will comply with K.S.A. 55-101, et seq., plus eventually plugging hole to K.C.C. specifications.

Date Signature of Operator or Agent

Douglas W. Thimesch Title

Vice President

RCH for KOME

Must be filed with the K.C.C. five (5) days prior to commencing well
 This card void if drilling not started within six (6) months of date received by K.C.C.


RECEIVED
 STATE CORPORATION COMMISSION

Important procedures to follow :

A Regular Section of Land
 1 Mile = 5,280 Ft.

SEP 5 1985
 09-05-1985
 CONSERVATION DIVISION
 Wichita, Kansas

1. Notify District office before setting surface casing.
2. Set surface casing by circulating cement to the top.
3. File completion forms ACO-1 with K.C.C. within 90 days of well completion, following instructions on ACO-1, side 1, and including copies of wireline logs.
4. Notify District office 48 hours prior to old well workover or re-entry.
5. Prior to plugging, prepare a plugging plan, then obtain agreement from the appropriate district office for an approved plugging plan.
6. Submit plugging report (CP-4) to K.C.C. after plugging is completed.
7. Obtain an approved injection docket number before disposing of salt water.
8. Notify K.C.C. within 10 days when injection commences or terminates.
9. If an alternate 2 completion, cement in the production pipe from below any usable water to surface within 120 days of spud date.

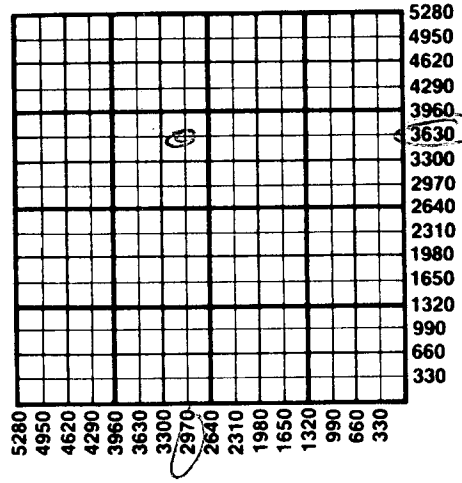

State Corporation Commission of Kansas
 Conservation Division
 200 Colorado Derby Building
 Wichita, Kansas 67202
 (316) 263-3238